


Section 14 Township 25S Range 1EWell No. #1 John LewisCompany Francis Raymond

NORTH

WEST

EAST

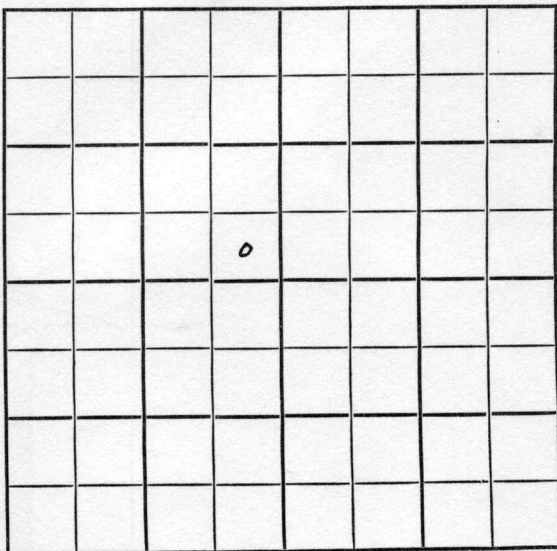

SOUTH

Sedgwick KANSAS

SEC.	TWP.	R.
14	25S	1E

WELL NO.

1 John Lewis

FARM

COMPANY

Francis Raymond

CONTRACTOR

Murfin Drlg.

Kurke Pool


Ft. from N. Line

330 Ft. from S. Line

330 Ft. from E. Line

Ft. from W. Line

SE SE NW

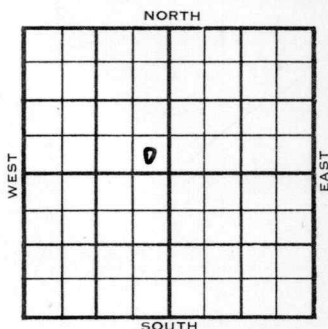

	ELEVATION	REPORT
1954	1441'	

9/15

Spud 6-30-54
 8" @ 180' w/140 sks
 1 ans 2332', KC 2548', B KC 2742',
 Burgen 3016'
 RTD 3020'
 5" @ 3017' w/50
 CO 3020'
 FU 130' fluid 12 hrs.
 Frac DD
 Miss 3030', VSSO RTD 3034'
 HFW
 D&A 7-7-54

FIRST REPORT

X

ABANDONED

FABEN GILSTRAP