


Map No. KANSAS Sec. 15 Twp. 25 R. 1EWell No. #1 Keagy. Farm
Western Kansas O & R Company

NORTH

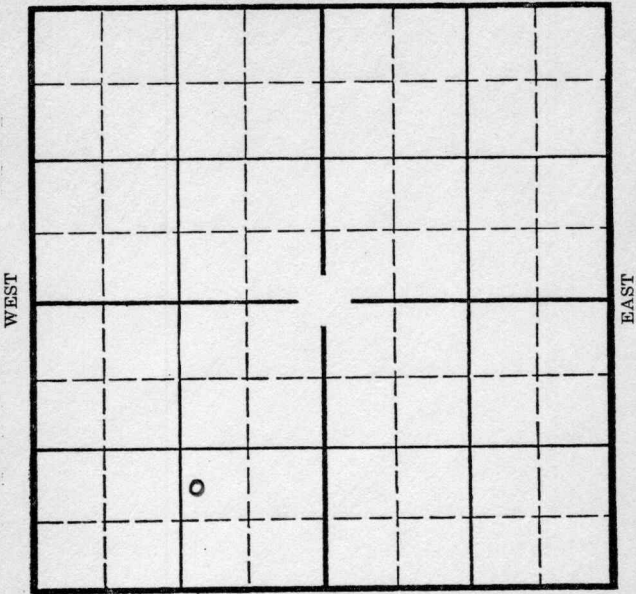

SOUTH

Location_____

Drilling Remarks_____

Rig Up_____

Drilling Remarks_____

RECORD

Cased_____ in._____ ft.

Sand_____

Gas_____

Oil_____

Total Depth_____

PRODUCTION

1st 24 hrs. Nat._____

1st 24 hrs. after shot_____

Gas_____ cu. ft.

Dry Hole_____

Abandoned_____

KANSAS

Map No. _____ Sec. 15 Twp. 25 R. 1-E

Well No. 1-Keagg _____ Farm

Western Kansas O & R _____ Company


_____ Ft. from N. Line

990 _____ Ft. from S. Line

1120 _____ Ft. from E. Line

_____ Ft. from W. Line

Elev. 1439

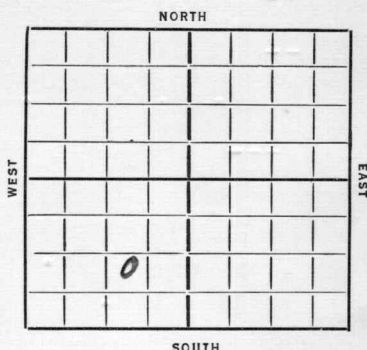Date
1936

REPORT

4/8 Machine

4/16 Rigging up.

4/23 Spud. 235'

4/30 Drlg. 615'.

5/7 Drlg. 1020'.

5/14 Drlg. 1300'.

5/21 Drlg. 1795'.

5/28 Drlg. 2320'.

6/4 K.C. 2519'. S.O. 2530-38 bbls est.
Drlg. 2580'.

6/11 Drlg. 2890'.

6/18 Miss. L. 3000'-03'. Show oil.
Under ream 6".6/25 Show oil 3111-15'. T.D. 3173'.
Under ream 6".

7/2 3240'. Fishing.

7/9-- 7/16-- 7/23-- 7/30--

8/6 Drlg. 3260'.

8/13 Viola 3397'. Pay 3397'-98'. Pump
7½ bbls of oil per hour.

8/20 Shut down.

8/27-- 9/3-- 9/10-- 9/18-- 9/24-- 10/1--

OVER

10/8--10/15--10/22--10/29--11/6--
11/12-- 11/19-- 11/27--12/3-- 12/10--
12/17--

12/24 P. B. 2000'.

12/29---

1937

1/7 Pump $7\frac{1}{2}$ bbls. water hour.
Shut down.

1/14 " " " " "

1/21 " " " " "

1/28 Shut down.

2/4 Drl g. 3243'.

2/11 3375' set 5" WOC

2//18 Viola 3378'. TD 3379'.
2700' oil show water 4 hrs.

2/24 Viola 3378'..
T. D. 3379'.
Potential 427 oil and 25% water.

COMPLETED

Bedgwick
Map No. 13 Sec. 15 Twp. 25 R. 1E

Well No. 112092

Western Kansas Oil & Gas Company

Contractor

SECTION PLAT

	0		

Ft. from N. Line

990 Ft. from S. Line

1120 Ft. from E. Line

Ft. from W. Line

FIRST REPORT

Location

Rig up

Drilling and Remarks:

Shack

RECORD

Cased in., ft.

Sand

Gas

Oil

Total Depth

PRODUCTION

1st 24 hrs. Nat.

1st 24 hrs. after shot

Gas Cu. Ft.

Dry Hole

Abandoned

Date

4/8/26 192

S. J. LEWIS

Scout

Map No. 13 Sec. 15 Twp. 25 R. 1E

Well No. 1 Heagy

Western Kansas O & R Company

Contractor

SECTION PLAT

	0		

_____ Ft. from N. Line

990 Ft. from S. Line

1120 Ft. from E. Line

_____ Ft. from W. Line

COMPLETED

Location _____

Rig up _____

Drilling and Remarks:

Viola 3378

Potential

427 oil and

25% water

RECORD

Cased _____ in., _____ ft.

Sand _____

Gas _____

Oil _____

Total Depth 3379

PRODUCTION

1st 24 hrs. Nat. _____

1st 24 hrs. after shot _____

Gas _____ Cu. Ft.

Dry Hole _____

Abandoned _____

Date

FEB 24 1937

19

S. J. LEWIS

Scout