


Map No. 140 Sec. 19 Twp. 25 R. 9

Well No. 9 Ladd Farm

Mid-Kansas Company

NORTH

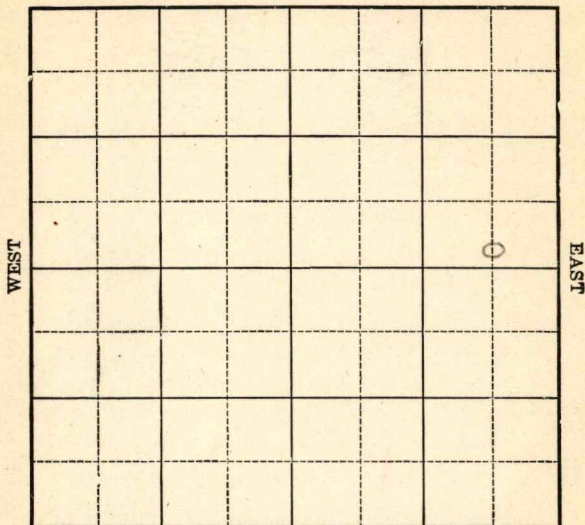

SOUTH

Location _____

Drilling Remarks

Rig Up

Drilling Remarks

RECORD

Cased _____ in. _____ ft.

Sand

Gas

Oil

Total Depth.....

PRODUCTION

1st 24 hrs. Nat.-----

1st. 24 hrs. after shot_____

Gas _____ cu. ft.

Dry Hole

Abandoned

Greenwood

Map No. Kansas Sec.

Well No. 9 Ladd


Mid-Kansas

Ft. from N. Line

200 Ft. from S. Line

660 Ft. from E. Line

Ft. from W. Line

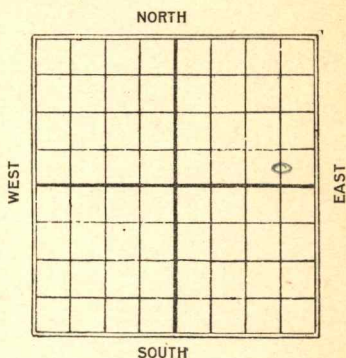

REPORT

1925

3/1	Location
-----	----------

4/10	Sand 2374	1st oil 2395
------	-----------	--------------

T.D. 2442 160 qt

150	Bbls
-----	------

Map No. 12 **KANSAS** Sec. 19 Twp. 25 R. 9

Well No. 9 Ladd Farm

Mid-Kansas Company

660 from E NORTH 200 from S.

FIRST REPORT

WEST EAST

SOUTH

Location ✓✓

Rig up _____

Drilling and Remarks:

RECORD

Cased _____ in. _____ Ft.

Sand _____

Gas _____

Oil _____

Total Depth _____

PRODUCTION

1st 24 hrs. Nat. _____

1st 24 hrs. after shot _____

Gas _____ Cu. Ft.

Dry Hole _____

Abandoned _____

Date

3/1

5

M. A. BENEAR

Map No. 15 Renda Sec. 19 Twp. 25 R. 9^EWell No. 9 LaddM. V. Renda

Company

Contractor

COMPLETED

SECTION PLAT

			o

Ft. from N. Line

200

Ft. from S. Line

660

Ft. from E. Line

Ft. from W. Line

Location

Rig up

Drilling and Remarks:

shot 160 gts150 bls

RECORD

Cased _____ in., _____ ft.

Sand 2374' 1st oil 2395'

Gas _____

Oil _____

Total Depth 2442'

PRODUCTION

1st 24 hrs. Nat. _____

1st 24 hrs. after shot _____

Gas _____ Cu. Ft.

Dry Hole _____

Abandoned _____

Date

APR 10 1925

192

Chas. L. Sherwood

Scout