


Map No. K Sec. 19 Twp. 25 R. 9
Well No. 6 Ladd Farm
Mud-Kansas Company

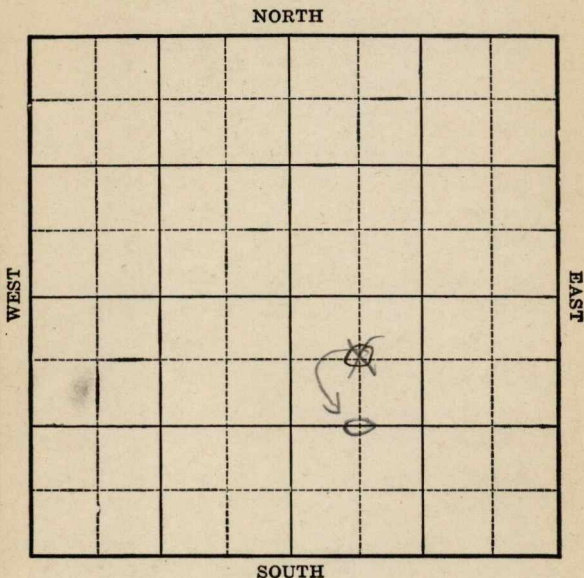

Location _____

Drilling Remarks:

Rig Up _____

Drilling Remarks:

RECORD

Cased _____ in. _____ ft.

Sand _____

Gas _____

Oil _____

Total Depth _____

PRODUCTION

1st 24 hrs. Nat. _____

1st 24 hrs. after shot _____

Gas _____ cu. ft.

Dry Hole _____

Abandoned _____

13 **KANSAS** Map No. _____ Sec. 19 Twp. 25 R. 9

Well No. 6-Ladd _____

Mid-Kansas Company _____

Contractor _____

FIRST REPORT

_____ Ft. from N. Line

1855 _____ Ft. from S. Line

_____ Ft. from E. Line

785 _____ Ft. from W. Line

SECTION PLAT

		⊙	

Location _____

Rig up _____

Drilling and Remarks:

Lac.

RECORD

Cased _____ in., _____ ft.

Sand _____

Gas _____

Oil _____

Total Depth _____

PRODUCTION

1st 24 hrs. Nat. _____

1st 24 hrs. after shot _____

Gas _____ Cu. Ft.

Dry Hole _____

Abandoned _____

Date

NOV 6 1924

M. A. BENEAR

192 _____

Scout

Map No. **KANSAS** Sec. 19 Twp. 25 R. 9

Well No. 6 Ladd

Mid-Kansas Company

Contractor


COMPLETED SECTION PLAT

_____ Ft. from N. Line

1320 Ft. from S. Line

_____ Ft. from E. Line

660 Ft. from W. Line

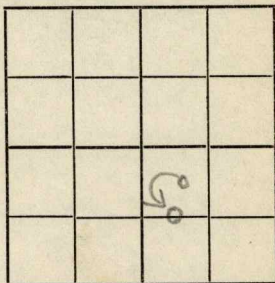

Location _____

Rig up _____

Drilling and Remarks:

sand 2384
7.0 2404
Bottom sand 2439
J.D. 2456
120/200 lbs.

RECORD

Cased _____ in., _____ ft.

Sand _____

Gas _____

Oil _____

Total Depth _____

PRODUCTION

1st 24 hrs. Nat. _____

1st 24 hrs. after shot _____

Gas _____ Cu. Ft.

Dry Hole _____

Abandoned _____

Date

1/14 5 192

M. A. BENEAR

Scout