Form 51-5M 5-37 Petrol


Sedgwick

KANSAS

Section 16 Township 25 Range 1-E

Well No. #3 Earl Black "A"

Company Prunty Production

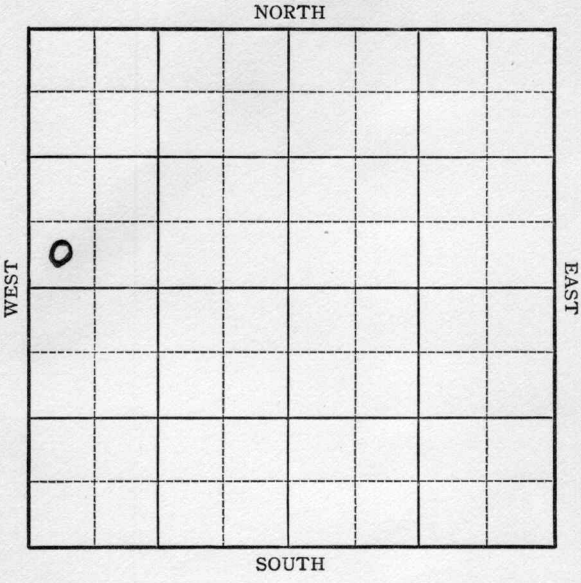


Form 252-A—5M—9-37 KANSAS Sedgwick

Sec. 16 Twp. 25 R. 1-E

Well No. #3 (#1) Earl Black "A" Farm

Prunty Prod. Company

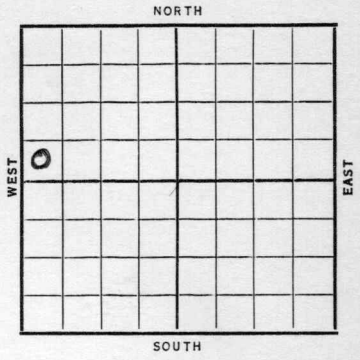

____ Ft. from N. Line

330 Ft. from S. Line

____ Ft. from E. Line

330 Ft. from W. Line

Elev. 1430

Date	REPORT
1937	
11/10	10" @ 191'. WOC.
11/19	T.D. 2447' fsg.
11/26	Chat 2990'. S.O. 3000-3010 &
	3030-40'. Drlg. 3209'.
12/3	Misner 3327 & 7".
	T.D. 3328'. No shows reported.
	RUST.
12/8	7" @ 3327'.
	Misner 3327'.
	T.D. 3338'.
	1000 acid.
	Potential 1296 bbls.
	Some water.
	COMPLETED

Form 26—1M Bks.—2-29

Sedgwick KANSAS

Map No. 13 Sec. 16 Twp. 25 R. 1E

Well No. 1 Earl Black "A"

Prunty Production Company

Contractor

FIRST REPORT

SW NW


Ft. from N. Line

330 Ft. from S. Line

Ft. from E. Line

330 Ft. from W. Line

SECTION PLAT

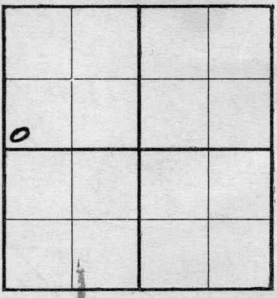

Location

Rig up

Drilling and Remarks:

10"-191

WOC

RECORD

Cased in., ft.

Sand

Gas

Oil

Total Depth

PRODUCTION

1st 24 hrs. Nat.

1st 24 hrs. after shot

Gas Cu. Ft.

Dry Hole

Abandoned

Date

NOV 10 1937 19

H. D. Hatfield Scout

Form 26—1M Bks.—2-29 KANSAS Sedgwick

Map No. 13 Sec. 16 Twp. 25 R. 1 E


Well No. 3 - Earl Black "A"

County Prod Company

Contractor

CORRECTION

SECTION PLAT

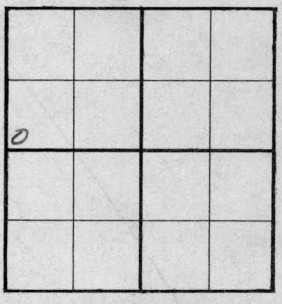

_____ Ft. from N. Line

330 Ft. from S. Line

_____ Ft. from E. Line

330 Ft. from W. Line

Location _____

Rig up _____

Drilling and Remarks:

first reported as #1 Earl Black "A"

RECORD

Cased _____ in., _____ ft.

Sand _____

Gas _____

Oil _____

Total Depth _____

PRODUCTION

1st 24 hrs. Nat. _____

1st 24 hrs. after shot _____

Gas _____ Cu. Ft.

Dry Hole _____

Abandoned _____

Date NOV 17 1937 19 ____

H. D. Hatfield Scout

Form 26—1M Bks.—2-29 Sedgwick KANSAS

Map No. 13 Sec. 16 Twp. 25 R. 1E

Well No. 3 Earl Black "A"

Prunty Production Company

Contractor

COMPLETED

SW NW


Ft. from N. Line

330 Ft. from S. Line

Ft. from E. Line

330 Ft. from W. Line

SECTION PLAT

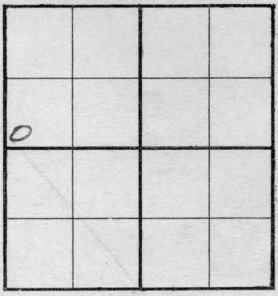

Location

Rig up

Drilling and Remarks:

1000 acid

PBT 1296

some water

RECORD

Cased 7 in., 3327 ft.

Sand Misner 3327

Gas

Oil

Total Depth 3338

PRODUCTION

1st 24 hrs. Nat.

1st 24 hrs. after shot

Gas Cu. Ft.

Dry Hole

Abandoned

Date

DEC 8 - 1937 19 H. D. Hatfield Scout