

KANSAS

Barton

Section 35 Township 20 Range 13WWell No. 1 DohrmannCompany Skelly

Rolling Green Pool

NORTH

							0

WEST

EAST

SOUTH

KANSAS

Barton



Sec. 35 Twp. 20 R. 13W

Well No. #1 Dohrmann Farm

Skelly

Company

Rolling Green Pool


Ft. from N. Line

330' Ft. from S. Line

330' Ft. from E. Line

Ft. from W. Line

SE NE

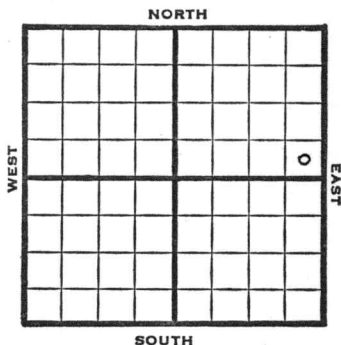

1948

Elev. -

R E P O R T

9/8 RUR

9/14 8"@ 497'
2595 fsg.

,9/21 Lansing 3244'
Drlg 3500'

9/29 "

10/6 Arbuckle 3618'
TD 3621'

ABANDONED

Map No. 82 Sec. 35 Twp. 20 R. 13W

Well No. 1 Dohrmann

Skelly Company

ABANDONED Contractor

SE NE

E. 1867
SECTION PLAT

 Ft. from N. Line

330 Ft. from S. Line

330 Ft. from E. Line

 Ft. from W. Line

Barton County

Location

Rig up

Drilling and Remarks:

Per 43618

RECORD

Cased in., ft.

Sand

Gas

Oil

Total Depth 3621

PRODUCTION

1st 24 hrs. Nat.

1st 24 hrs. after shot

Gas Cu. Ft.

Dry Hole

Abandoned

Date

OCT 6 1948 19

S. J. LEWIS Scout

Barton County Kansas State
Map No. _____ Sec. 35 Twp. 20 R. 13W

Well No. 1 Dohrmann

Skelly Company

FIRST REPORT Contractor

SE NE

SECTION PLAT

_____ Ft. from N. Line

330 Ft. from S. Line

330 Ft. from E. Line

_____ Ft. from W. Line

Rolling Green Pool

Remarks:

R U R

Date
SEP 8 1948

Scout
S. J. LEWIS