

Barton

DX 78-1

KANSAS

Section 34 Township 20 Range 13W


Well No. #1 McDonald

Company Rocket Drlg. Co.

NORTH

WEST

EAST

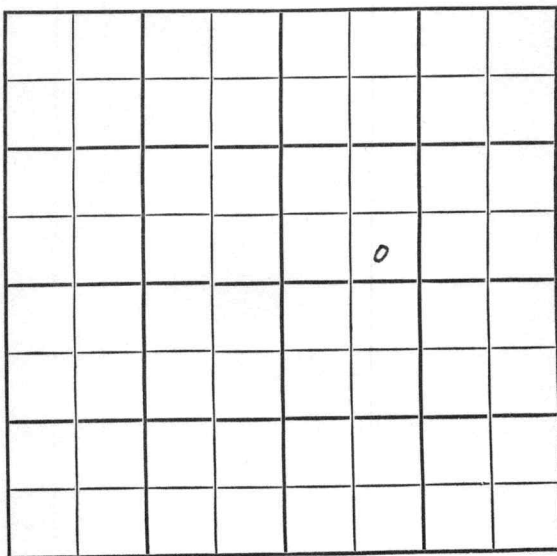

SOUTH

Barton KANSAS

SEC.	TWP.	R.
34	20	13W

WELL NO.

1 McDonald

FARM

COMPANY

Rocket Drlg. Co.

CONTRACTOR

Co. Tools


Wildcat

Ft. from N. Line

330 Ft. from S. Line

Ft. from E. Line

990 Ft. from W. Line

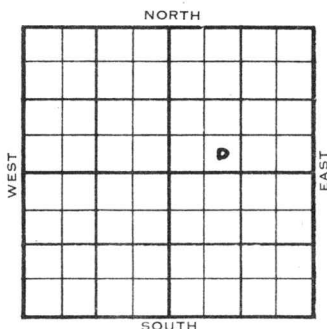

SE SW NE

1954	ELEVATION	REPORT
	1877'	

9/29 Location

1955
2/2

Spud 10-4-54 - Oil Well

TD 3592'

8-5/8" @ 252'

Heeb. 3128', Br. lime 3248', Mans. 3262'

DST 3250-3340', opn 1 hr., rec. 290' O&GCM, 190' HO&GCM, 700#

DST 3379-3413', opn 1 hr., rec. 30' mud, 490#

DST 3417-90', opn 1 hr., rec. 30' mud 170#

Cong. 3493', Arb. 3547',

TD 3551'

5" @ 3549'

DD 3564', 500A

DD 3592', SP 3363

9/3337-40', 48/3316-29,

B/20 go 1 hr., 1000A

S/3 bfph 30% wtr. 5 hrs.


9/3302-05, 24/3290-98, 24/3278-86,

24/3266-74, 2000A

P/40 bopd 3 days

Comp. 50 bopd

County Barton State Kansas
 Sec. 34 (Blk.) 20 (Sur.) 13W Map No.
 Operator Rocket Drlg.
 Well No. 1 Farm McDonald
 Elev. 1877 Location SE SW NE

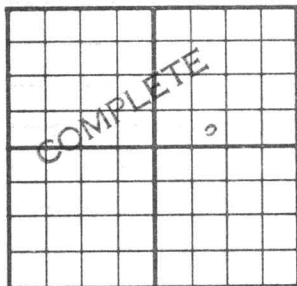

330 Ft. From S Line NE
990 Ft. From W Line Quarter

1st. Report

Completion FEB 2 1955

Remarks Wildcat

Co. tools

Spudding Date 10-4-54

Drlg. Data Oil well TD 3592

8 5/8" @ 252 Heeb. 3128 Br. lime 3248

Lans. 3262 DST 3250-3340 open 1 hr.

Rec. 290' o & gcm 190' ho & gcm 700#

DST 3379-3413 open 1 hr. Rec. 30' mud

490# DST 3417-90 open 1 hr. Rec.

30' mud 170# Cong. 3493 Arb. 3547

TD 3551 5" @ 3549 DD 3564 500 A

DD 3592 SP 3363 9/ 3337-40 48/ 3316-29

B/ 20 go 1 hr. 1000 A S/ 3 bfph

30% wtr. 5 hr. 9/ 3302-05 24/ 3290-98

24/ 3278-86 24/ 3266-74 2000 A

P/ 40 bopd 3 days Comp. 50 bopd

FABEN GILSTRAP

FABEN GILSTRAP