


Map No. 75 Sec. 19 Twp. 25 R. 9

Well No. 8 Ladd Farm


NORTH

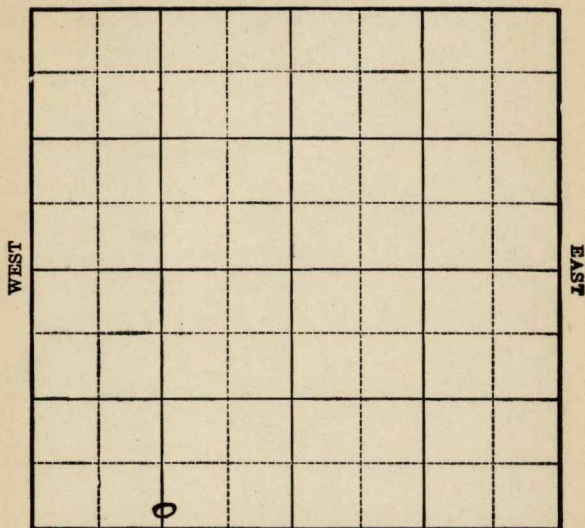

SOUTH

Location _____

Drilling Remarks:

Rig Up _____

Drilling Remarks:

RECORD

Cased _____ in. _____ ft.

Sand _____

Gas _____

Oil _____

Total Depth_____

PRODUCTION

1st 24 hrs. Nat. _____

1st 24 hrs. after shot

Gas _____ cu. ft.

Dry Hole _____

Abandoned _____

15 **KANSAS** Map No. Sec. 19 Twp. 25 R. 9
 Well No. 8- Ladd.
 Mud-Kansas Company

Contractor

FIRST REPORT

SECTION PLAT

-----Ft. from N. Line

200 -----Ft. from S. Line

-----Ft. from E. Line

1320 -----Ft. from W. Line

Location -----

Rig up -----

Drilling and Remarks:

RECORD

Cased ----- in., ----- ft.

Sand -----

Gas -----

Oil -----

Total Depth -----

PRODUCTION

1st 24 hrs. Nat. -----

1st 24 hrs. after shot -----

Gas ----- Cu. Ft.

Dry Hole -----

Abandoned -----

Date
 SEP 9 1924

192

Scout

Map No. 15 **KANSAS** Sec. 19 Twp. 25 R. 9

Well No. 8 Ladd

Mid-Kansas Company

Contractor

COMPLETED

SECTION PLAT

_____ Ft. from N. Line

200 Ft. from S. Line

_____ Ft. from E. Line

1320 Ft. from W. Line

Location _____

Rig up _____

Drilling and Remarks:

sand 2478-2493

7D. 2525

P.B. 2493

40/50

RECORD

Cased _____ in., _____ ft.

Sand _____

Gas _____

Oil _____

Total Depth _____

PRODUCTION

1st 24 hrs. Nat. _____

1st 24 hrs. after shot _____

Gas _____ Cu. Ft.

Dry Hole _____

Abandoned _____

Date

NOV 12 1924

192

M. A. BENEAR

Scout