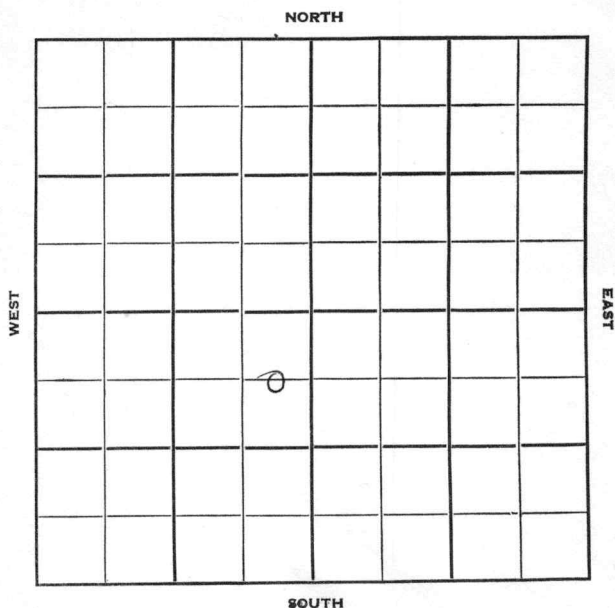


Section 1 Township 20 Range 14WWell No. #1 MertanCompany E. H. Adair

Barton

KANSAS

Sec. 1 Twp. 20 R. 14W ✓

Well No. #1 Mertan Farm

E. H. Adair Company

E. H. Adair Contractor

Wildcat


660 Ft. from N. Line

 Ft. from S. Line

330 Ft. from E. Line

 Ft. from W. Line

C E/2 NE SW

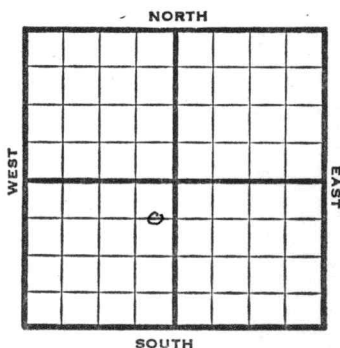

1951

Elev. 1871' REPORT

10/31

Spud 10-28-51
8" @ 782' WOC

12/5

Spud 10-28-51
D & A TD 3545' 8" @ 782'
Anhy 778' Heeb 3108' Br. lime 3209'
Lans. 3224'
DST 3225-63 open 1/2 hr. rec 40' mud
Arb. 3496-99'
5" @ 3499' TD 3545' HFW PB 3460'
24/3437-45 32/3386-94
36/3370-76 water PB 3360'
36/3348-54 24/3296-3300
12/3300-02 water PB 3285
36/3268-74 36/3216-22 36/3222-28
1000 A FU 50' oil 1500' water
15 hr. DP to 3335 water FU 1100'
water SSO S/2 BW & SSO ph
36/3302-08 water S/2 1/2 BW^{PH}
D & A


ABANDONED

County Barton State KansasSec. 1 (Blk. Twp.) 20 (Sur. Rge.) 14W Map No.Operator E. H. AdairWell No. 1 Farm MertanElev. 1871 Location C E L NE SW660 Ft. From N Line SW330 Ft. From E Line Quarter

1st. Report

Completion DEC 5 1951Remarks WildcatAdair - Contr.Spudding Date 10-28-51Drlg. Data D & A TD 35458" @ 782 Anhy 778 Heeb. 3108Br. lime 3209 Lans. 3224 DST 3225-63open $\frac{1}{2}$ hr. Rec. 40' mud Arb. 3496-995" @ 3499 TD 3545 HFW PB 346024/ 3437-45 32/ 3386-94 36/ 3370-76water PB 3360 36/ 3348-54 24/ 3296-3300 12/ 3300-02 water PB 328536/ 3268-74 36/ 3216-22 36/ 3222-281000 A FU 50' oil 1500' water 15 hr.DP to 3335 water FU 1100' water SSOS/ 2 bw & SSO ph 36/ 3302-08 waterS/ 2 $\frac{1}{2}$ bwph D & A

J. E. TYRA

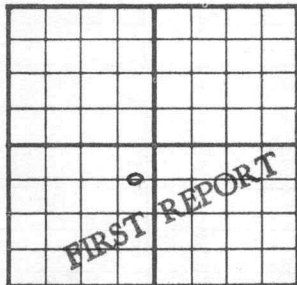County Barton State KansasSec. 1 (Blk.) 20 (Sur.) 14W Map No.Operator E. H. AdairWell No. 1 Farm MertanElev. Location C E/2 NE SW660 Ft. From N Line SW330 Ft. From E Line Quarter1st. Report OCT 31 1951

Completion

Remarks

E. H. Adair - Contr.Spudding Date 10-28-51Drlg. Data Wildcat8" @ 782' W.O.C.J. E. TYRA