


Map No. Kans Sec. 19 Twp. 25 R. 9
Well No. 10 Ladd Farm _____
Mid-Kansas Company _____

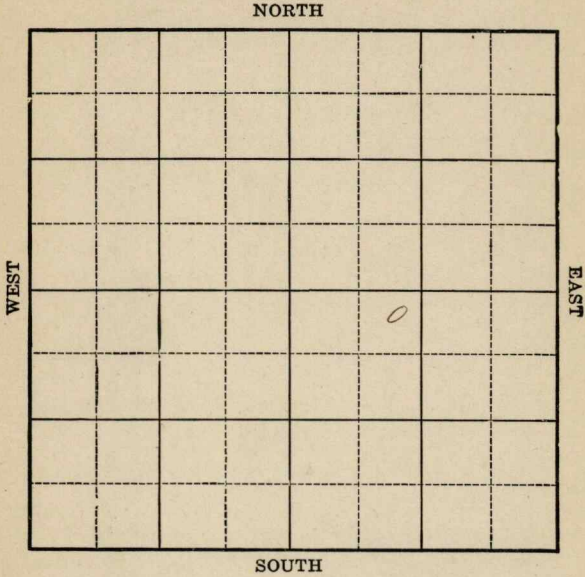

Location _____
Drilling Remarks _____

Rig Up _____
Drilling Remarks _____

RECORD

Cased _____ in. _____ ft.
Sand _____
Gas _____
Oil _____
Total Depth _____

PRODUCTION

1st 24 hrs. Nat. _____
1st. 24 hrs. after shot _____
Gas _____ cu. ft.
Dry Hole _____
Abandoned _____

Map No. Kansas Sec. 19 Twp. 25 R 9Well No. 10 Ladd FarmMud - Kansas Company

NORTH


200 Ft. from N. Line

Ft. from S. Line

Ft. from E. Line

760 Ft. from W. Line

WEST

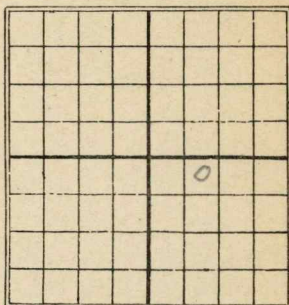

EAST

SOUTH

Date

REPORT

19253/24Rig up5/212386-2458100 gts160 Bbls

Map No. **KANSAS** Sec. 19 Twp. 25 R. 9

 Well No. 10 Ladd
Mild-Kansas Company

Contractor


FIRST REPORT

SECTION PLAT

200 Ft. from N. Line

Ft. from S. Line

Ft. from E. Line

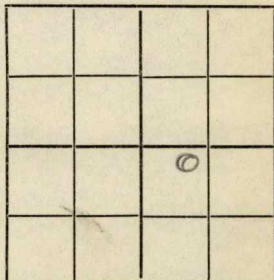760 Ft. from W. Line


Location

Rig up

Drilling and Remarks:

RECORD

Cased in., ft.

Sand

Gas

Oil

Total Depth

PRODUCTION

1st 24 hrs. Nat.

1st 24 hrs. after shot

Gas Cu. Ft.

Dry Hole

Abandoned

Date

3/24 192

M. A. BENEAR

Scout

Map No. 15 1/2 bds Sec. 19 Twp. 25 R. 9Well No. 10 La 20Mid-16n 40 Company

Contractor

COMPLETED

SECTION PLAT

200 Ft. from N. Line

Ft. from S. Line

Ft. from E. Line

760 Ft. from W. Line

		0	

Location

Rig up

Drilling and Remarks:

RECORD

Cased 2386 in., 2438 ft.

Sand

Gas

Oil

Total Depth 2438

PRODUCTION

1st 24 hrs. Nat.

1st 24 hrs. after shot

Gas Cu. Ft.

Dry Hole

Abandoned

Date

MAY 21 1925

192

CHAS. L. SHERWOOD

Scout