


Form 51 5M 8-24 16567

Map No. Kans Sec. 19 Twp. 25 R. 9^E

Map No. 1002 Sec. 11 Twp. 22 R. 1
Well No. 13 Ladd Farm
mid-Kansas Company

NORTH

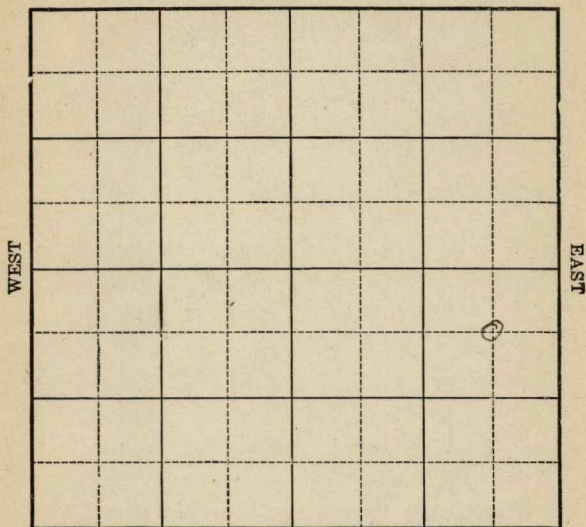

SOUTH

Location _____

Drilling Remarks

Rig Up_____

Drilling Remarks

RECORD

Cased _____ in. _____ ft.

Sand

Gas

Oil

Total Depth _____

PRODUCTION

1st 24 hrs. Nat.-----

1st. 24 hrs. after shot_____

Gas.....cu. ft.

Dry Hole


Abandoned

Map No. _____ Sec. 19 Twp. 25 R. 9^EWell No. 12 Ladd Farm _____
Mid-Kansas Company660 Ft. from N. Line

_____ Ft. from S. Line

660 Ft. from E. Line

_____ Ft. from W. Line

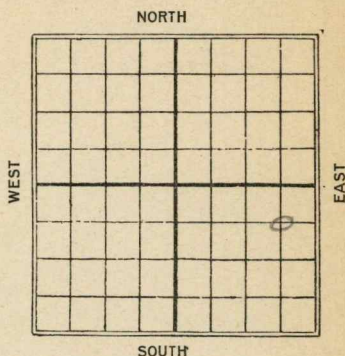

C

Date

REPORT

19254/10 Timbers5/29 Drly 13006/5 ✓ 19006/12 \$ 2370-2439 - lost 160 gts to 1300.
fluid in hole6/18 2370-2439 160 gts
125 Bbls

Map No. 13 Kinds Sec. 19 Twp. 25 R. 9^EWell No. 12 LaosMid-Kinds

Company

Contractor

FIRST REPORTS

SECTION PLAT

660 Ft. from N. Line

Ft. from S. Line

660 Ft. from E. Line

Ft. from W. Line

			o

Location

Rig up

Drilling and Remarks:

Timbers

RECORD

Cased _____ in., _____ ft.

Sand _____

Gas _____

Oil _____

Total Depth _____

PRODUCTION

1st 24 hrs. Nat. _____

1st 24 hrs. after shot _____

Gas _____ Cu. Ft.

Dry-Hole _____

Abandoned _____

Date

APR 10 1925

192

Chas. L. Sherwood Scout

Map No. 15 Sec. 19 Twp. 25 R. 9

Well No. 12 Ladd


Contractor

COMPLETED

SECTION PLAT

660 Ft. from N. Line

_____ Ft. from S. Line

660 Ft. from E. Line

_____ Ft. from W. Line

			o

Location _____

Rig up _____

Drilling and Remarks:

RECORD

Cased _____ in., _____ ft.

Sand 2370-2439

Gas _____

Oil _____

Total Depth 2439'

PRODUCTION

1st 24 hrs. Nat. _____

1st 24 hrs. after shot _____

Gas _____ Cu. Ft.

Dry Hole _____

Abandoned _____

Date

JUN 18 1925

192

CHAS. L. SHERWOOD

Scout