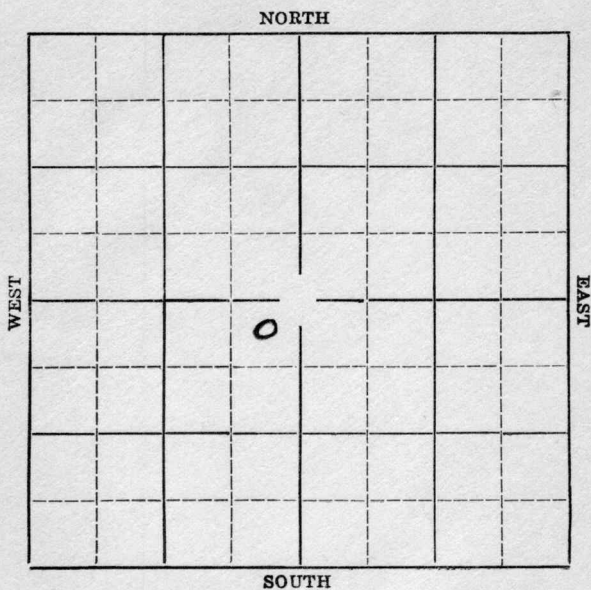


Section 16 Township 25 Range 1-EWell Number #3 GoodrichCompany Continental et al

Well No. #3 Goodrich Farm
Continental Oil et al Company

_Ft. from W. Line


[illegible]

Seelyewick
Map No. 13 Sec. 16 Twp. 25 R. 12

Well No. 3 Goodrich

Continental & Co. Company

Contractor

SECTION PLAT

330 Ft. from N. Line

_____ Ft. from S. Line

330 Ft. from E. Line

_____ Ft. from W. Line

FIRST REPORT

Location _____

Rig up _____

Drilling and Remarks:

Dr 192440

RECORD

Cased _____ in., _____ ft.

Sand _____

Gas _____

Oil _____

Total Depth _____

PRODUCTION

1st 24 hrs. Nat. _____

1st 24 hrs. after shot _____

Gas _____ Cu. Ft.

Dry Hole _____

Abandoned _____

Date

OCT 21 1936

19


S. J. LEWIS Scout

Olathe KANSAS

Map No. 13 Sec. 16 Twp. 25 R. 1EWell No. 3 GoodrickContinental Company

Contractor

SECTION PLAT

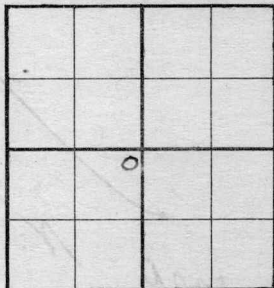330 Ft. from N. Line

_____ Ft. from S. Line

330 Ft. from E. Line

_____ Ft. from W. Line

COMPLETED

Location _____

Rig up _____

Drilling and Remarks:

Dolomite 3304Pump 487 oil172 water

RECORD

Cased _____ in., _____ ft.

Sand _____

Gas _____

Oil _____

Total Depth 3336

PRODUCTION

1st 24 hrs. Nat. _____

1st 24 hrs. after shot _____

Gas _____ Cu. Ft.

Dry Hole _____

Abandoned _____

Date

NOV 18 1936 19

S. J. LEWIS Scout