


Map No. Kansas Sec. 19 Twp. 25 R. 9
 Well No. 4 Ladd Acre #6 Farm
Mid-Kansas Company

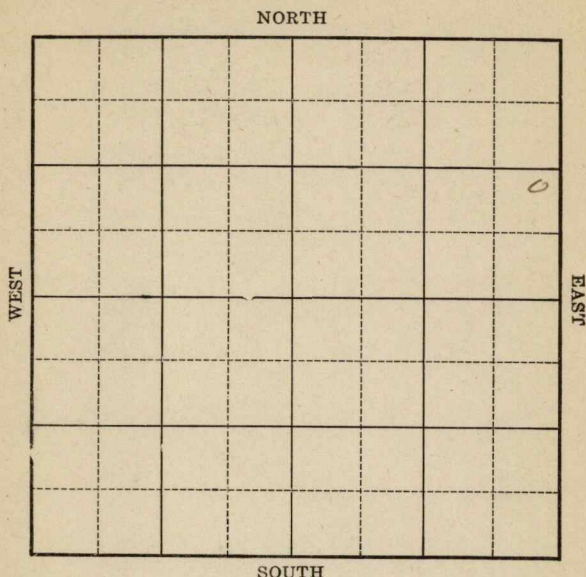

Location _____

Drilling Remarks

Rig Up _____

Drilling Remarks

RECORD

Cased _____ in. _____ ft.

Sand _____

Gas _____

Oil _____

Total Depth _____

PRODUCTION

1st 24 hrs. Nat. _____

1st 24 hrs. after shot _____

Gas _____ cu. ft.

Dry Hole _____

Abandoned _____

Greenwood Co
 Map No. Kansas Sec. 19 Twp. 25 R 9
 Well No. 4 Ladd Acre #6 Farm
Mid-Kansas Company

NORTH

WEST

EAST

SOUTH

Ft. from N. Line

1010 Ft. from S. Line565 Ft. from E. Line

Ft. from W. Line

Date

REPORT

192512/3

Location

12/10

Rm

12/17

Spudding

12/23

Only 300'

12/31

Only 600'

19261/8

Only 900'

1/14 1/20

✓ 1900'

1/27

1st oil 2373 125 lbs.

Sand 2357-2404 F.O. 2404

Sherwood Co

Map No. KANSAS 15 Sec. 19 Twp. 25 R. 9Well No. 4 hoo. Acct # 6M. S. - S. S. S. Company

Contractor

SECTION PLAT

			o

Ft. from N. Line

1010 Ft. from S. Line565 Ft. from E. Line

Ft. from W. Line

FIRST REPORTS

Location ☒

Rig up

Drilling and Remarks:

RECORD

Cased _____ in., _____ ft.

Sand _____

Gas _____

Oil _____

Total Depth _____

PRODUCTION

1st 24 hrs. Nat. _____

1st 24 hrs. after shot _____

Gas _____ Cu. Ft.

Dry Hole _____

Abandoned _____

Date

DEC 3 1925

192

CHAS. L. SHERWOOD

Scout

31600wood Co
 15 KANSAS Sec. 19 Twp. 25 R. 9
 Map No. 4 Add. Acct #6
 Well No. Mid-Kansas
 Company
 Contractor

COMPLETED

SECTION PLAT

			0

Ft. from N. Line

1010

Ft. from S. Line

565

Ft. from E. Line

Ft. from W. Line

Location

Rig up

Drilling and Remarks:

1st oil 2373'

809 125 bhs.

RECORD

Cased in. ft.

Sand 2357- 2404

Gas

Oil

Total Depth 2404

PRODUCTION

1st 24 hrs. Nat.

1st 24 hrs. after shot

Gas Cu. Ft.

Dry Hole

Abandoned

Date

JAN 27 1926

192

CHAS. L. SHERWOOD

Scout