

Section 16 Township 25 Range 1EWell No. #7 W. GoodrichCompany Continental Oil

NORTH

WEST

EAST

SOUTH

Sedgwick

KANSAS

SEC.

TWP.

R.

16

25

1 E

WELL NO.

7 W. Goodrich

FARM

COMPANY

Continental Oil

CONTRACTOR

G-M-R

Goodrich Pool

Ft. from N. Line

1950

Ft. from S. Line


Ft. from E. Line

2310

Ft. from W. Line

SW C E L NE SW

NORTH

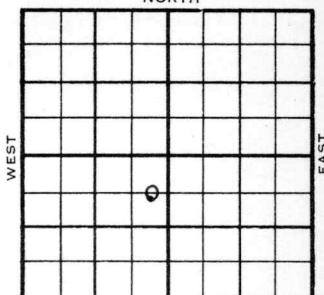

SOUTH

ELEVATION

1435'

REPORT

1954

SWDW

1/20

Spud 1-14-54

10" @ 200

Drlg. 2121'

2/24

Spud 1-14-54

SWD Well

TD 4212'

10" @ 200'

Br. Lime 2252', Lans 2328', KC 2545'

DST 2585'-2626' opn 1 hr, rec 30' Mud 125#

DST 2628'-62' opn 1 hr, rec 40' sg & ocm, 60' o & gcm 835#

DST 2700'-35' opn 1 hr, rec 165' ho & gcm 570# B KC 2735' Miss 2989'

Kh. 3266', Hunton 33 35', Maq. 3359'

Viola 3382'

DST 3382'-90' opn 1 hr, rec 1777' sul

Wtr. 1270# Simp 3411', Arb 3493'

TD 4212'

7" @ 3625'

PreCamb. 4179',

CO to 4212'

4000 A

Comp SWD Well

ABANDONED

J. G. McGEHEE

County Sedgwick State Kansas
 Sec. 16 (Blk. 25 (Sur. 1E Map No. 1E)
 Operator Continental Oil
 Well No. 7 Farm W. Goodrich
 Elev. 1435 Location C E L N E S W



1950 Ft. From S Line Sec.
2310 Ft. From W Line Quarter
 Ist. Report
 Completion FEB ' 4 1954
 Remarks Goodrich Pool
G-M-R - Contr.
 Spudding Date 1-14-54

Drlg. Data SWD well TD 4212
10" @ 200 Br. lime 2252 Lans. 2328
KC 2545 DST 2585-2626 open 1 hr.
Rec. 30' mud 125# DST 2628-62
open 1 hr. Rec. 40' sg & ocm 60' o &
gcm 835# DST 2700-35 open 1 hr.
Rec. 165' ho & gcm 570# B KC 2735
Miss. 2989 Kh. 3266 Hunton 3335
Maq. 3359 Viola 3382 DST 3382-90
open 1 hr. Rec. 1777' sul. wtr. 1270#
Simp. 3411 Arb. 3493 TD 4212
7" @ 3625 PreCamb. 4179 CO to 4212
4000 A Comp. SWD well

J. G. McGEHEE