
Sedgwick

Form 51—5M—2-29—34703

Map No. KANSAS Sec. 16 Twp. 25 R. 1E

Well No. 1 Mead Farm

Stearns-Streeter etal Company

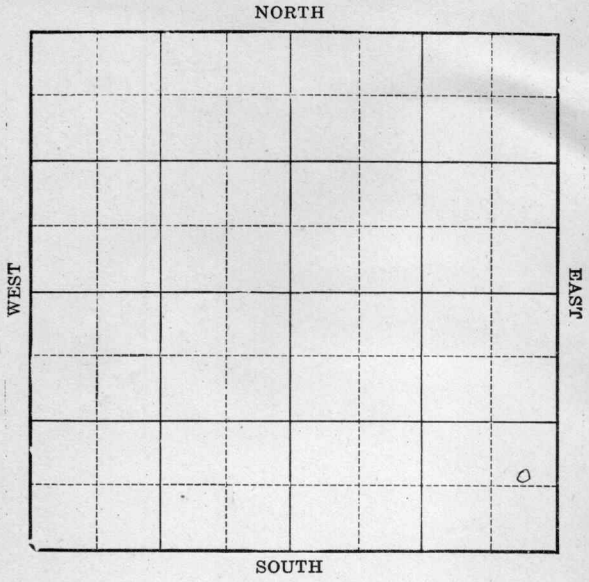

Location

Drilling Remarks

Rig Up

Drilling Remarks

RECORD

Cased in. ft.

Sand

Gas

Oil

Total Depth

PRODUCTION

1st 24 hrs. Nat.

1st 24 hrs. after shot

Gas cu. ft.

Dry Hole

Abandoned


Sedgwick

FORM 252A-5M-6-30-PETROL

Map No. KANSAS Sec. 16 Twp. 25 R. 1E

Well No. 1 Mead Farm

Stearns-Streeter etal Company

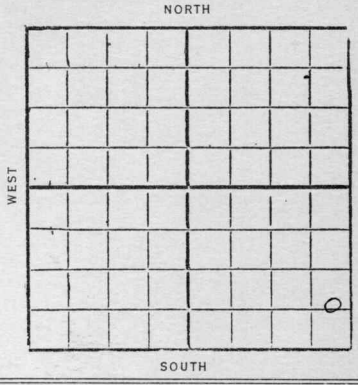

____ Ft. from N. Line

700 Ft. from S. Line

247 Ft. from E. Line

____ Ft. from W. Line

1932

Date	REPORT
	Loc
5/11	Bldg rig
5/18	Spdn up
5/25	Drlg 510'
6/1	" 1440'
6/8	" 2062'
6/15	10"-2415
6/22	Drlg 2422'
	Top Chat 3060
6/29	Drlg 3090'
	Show Oil 3080-87
7/6	HFW 3087-90
	8"-3101
	Drlg 3118'
	6"-3275
7/13	Drlg 3343
	Top Viola 3427
7/20	TD 3453 HFW
	Dry & Abandon

Form 26—1M Bks.—9-26

Deeghies

13 KANSAS

Map No. ..... Sec. 16 Twp. 25 R. 1 E


Well No. 1 Mead

Stearns - Streeter Gal Company

Contractor

FIRST REPORTS

SECTION PLAT

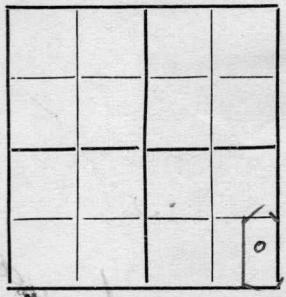

..... Ft. from N. Line

700 Ft. from S. Line

247 Ft. from E. Line

..... Ft. from W. Line

20 acres

Location ✓

Rig up

Drilling and Remarks:

RECORD

Cased ..... in., ... ft.

Sand

Gas

Oil

Total Depth

PRODUCTION

1st 24 hrs. Nat.

1st 24 hrs. after shot

Gas ..... Cu. Ft.

Dry Hole

Abandoned

Date

MAY 1 1 1932 CHAS. L. SHERWOOD

..... 192..... Scout

Form 26—1M Bks.—9-28

Seagrick

13 KANSAS E

Map No. ..... Sec. 16 Twp. 25 R. 1

Well No. 1 Mead

Stearns-Streeter Oil Co. Company

..... Contractor

COMPLETED

SECTION PLAT


..... Ft. from N. Line

700 Ft. from S. Line

347 Ft. from E. Line

..... Ft. from W. Line

ABANDONED

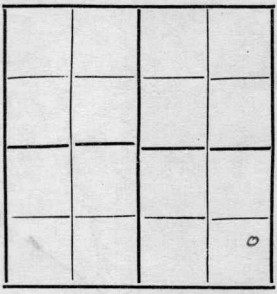

Location .....

Rig up .....

Drilling and Remarks:

Top Viola 3427

DTD 3453

HFW

RECORD

Cased ..... in., ... ft.

Sand .....

Gas .....

Oil .....

Total Depth 3453

PRODUCTION

1st 24 hrs. Nat. .....

1st 24 hrs. after shot .....

Gas ..... Cu. Ft.

Dry Hole ✓

Abandoned ✓

Date

JUL 20 1932 CHAS. L. SHERWOOD

..... 192.... ..... Scout