


Map No. Kansas Sec. 5 Twp. 25 R. 10
Well No. 1 Robbins Farm
H. J. Wilson Company

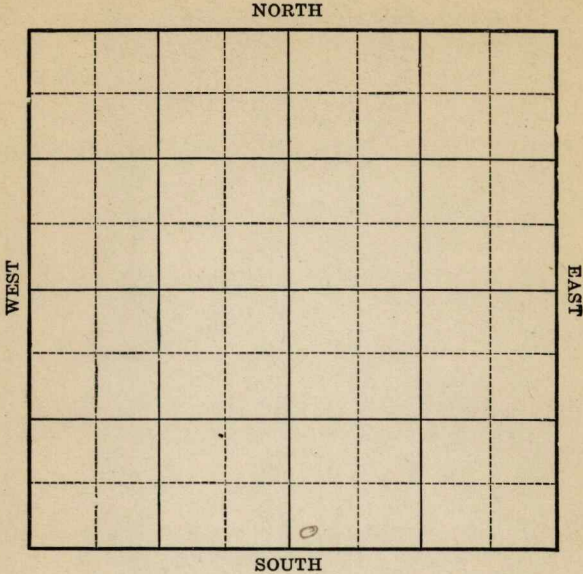

Location _____
Drilling Remarks _____

Rig Up _____
Drilling Remarks _____

RECORD

Cased _____ in. _____ ft.
Sand _____
Gas _____
Oil _____
Total Depth _____

PRODUCTION

1st 24 hrs. Nat. _____
1st. 24 hrs. after shot _____
Gas _____ cu. ft.
Dry Hole _____
Abandoned _____

Map No. _____ Sec. 5 Twp. 25 R. 10Well No. 1 Robbins Farm _____
H. J. Wilson Company _____


Ft. from N. Line

300 Ft. from S. Line

Ft. from E. Line

300 Ft. from W. LineC

NORTH

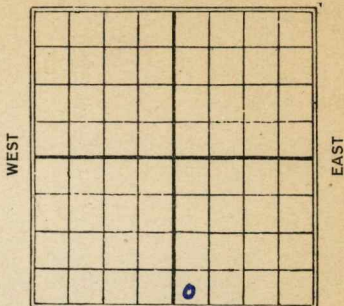

SOUTH

Date REPORT

1925	
6/12	<u>Regr up.</u>
6/19	
6/26	<u>Drilg. 300</u>
7/3	
7/10	
7/17	log 820
7/24	- 920'
7/31	
8/7	A.D. 1344 Little trouble
8/14	
8/20	
8/27	
9/3	
9/11	
9/16	
9/24	
10/1	Drilg 1610
10/8	2140
10/16	Abandoned 2218

Map No. 16 Sec. 5 Twp. 25 R. 10Well No. 1 RobbinsH. J. Wilson Company

Contractor

SECTION PLAT

Ft. from N. Line

300 Ft. from S. Line

Ft. from E. Line

300 Ft. from W. Line

FIRST REPORTS

Location

Rig up

Drilling and Remarks:

Rigging up

RECORD

Cased _____ in., _____ ft.

Sand _____

Gas _____

Oil _____

Total Depth _____

PRODUCTION

1st 24 hrs. Nat. _____

1st 24 hrs. after shot _____

Gas _____ Cu. Ft.

Dry Hole _____

Abandoned _____

Date

JUN 12 1925192CHAS. L. SHERWOC

Scout

W. Sherwood Co.
 K 16 **KANSAS** Sec. *5* Twp. *25* R. *10*
 Map No. _____
 Well No. *1* *Robbins*
H. J. Weldon Company
 Contractor

COMPLETED

SECTION PLAT

_____ Ft. from N. Line

300 _____ Ft. from S. Line

_____ Ft. from E. Line

300 _____ Ft. from W. Line

ABANDONED

Location _____

Rig up _____

Drilling and Remarks:

Tap line 2179
Dry & shot
L.D. 2218

RECORD

Cased _____ in., _____ ft.

Sand _____

Gas _____

Oil _____

Total Depth *2218'*

PRODUCTION

1st 24 hrs. Nat. _____

1st 24 hrs. after shot _____

Gas _____ Cu. Ft.

Dry Hole _____

Abandoned _____

Date

OCT 16 1925

192

CHAS. L. SHERWOOD

Scout