

O.W.W.O.

Section 31 Township 20 Range 13W

Well No. #1 Hiss

Company W L Graham etal.

Hiss

NORTH

WEST

EAST

				o			

SOUTH

Sec. 31 Twp. 20 R. 13W

Well No. #1 Hiss Farm

W. L. Graham et al Company

Hiss


330 Ft. from N. Line

_____ Ft. from S. Line

_____ Ft. from E. Line

330 Ft. from W. Line

NW NE

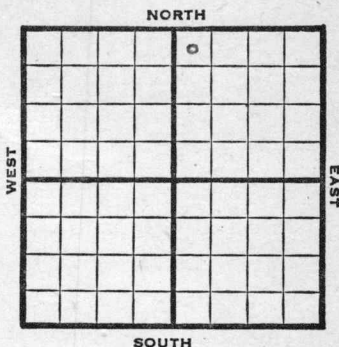

1947

Elev. 1901' REPORT

12/3

8" @ 147'
Heebner 3038'
Brown Line 3149'
Lansing 3161'
Granite 3314'
TD 3315'
5" @ 3314'
RUST

12/10

"

12/17

"

12/30

12 shots 3252-56'
4000 acid SO

1948

1/7

"

1/14

"

1/21

"

1/26

"

2/4

Lans. 3161' Granite 3314'
5" @ 3314' Perf.
3500 acid
Pump 114 Pot
Gr. 37.0
TD 3315'

COMPLETED

OVER

1954

O.W.W.O.

10/20 8" @ 147'
Heeb 3038', Br. Lime 3149', KC 3161'
PreCamb. 3314'
OTD 3315'
Perf 3252-56 114 bo 14 hr.
CO to 3306'
perf 3303-06 1000 A S/ 1½ boph
SP 3290
13/ 3283-88 1000 A S/ 8 boph.

10/27 Oil Well
TD 3315'
8" @ 147'
Heeb 3038', Br. Lime 3149', KC 3161'
PreCamb. 3314'
OTD 3315'
Perf 3252-56 114 bo 14 hr.
CO to 3306'
perf 3303-06 1000 A S/ 1½ boph
SP 3290'
13/ 3283-88 1000 A S/ 8 boph
CO to 3305
5" @ 3295'
1000 A S/ 1 boph SP 3290 13/ 3283-8
8 1000 A S/ 8 boph
10 hr.
P/ 61 bo 24 hr.
Comp

COMPLETED

Map No. _____ Sec. 31 Twp. 20 R. 13W

Well No. 1 Hiss

W. L. Graham etal. Company

FIRST REPORT

Contractor

NW NE


SECTION PLAT

330 Ft. from N. Line

_____ Ft. from S. Line

_____ Ft. from E. Line

330 Ft. from W. Line

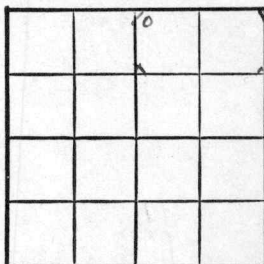

Barton County

Location _____

Rig up _____

Drilling and Remarks:

8" @ 147
 Heebner 3038
 Br. lime 3149
 Lans. 3161
 Granite 3314
 TD 3315
 5" @ 3314 RUST

RECORD

Cased _____ in., _____ ft.
 Sand _____
 Gas _____
 Oil _____
 Total Depth _____

PRODUCTION

1st 24 hrs. Nat. _____
 1st 24 hrs. after shot _____
 Gas _____ Cu. Ft.
 Dry Hole _____
 Abandoned _____

Date

DEC 3 1947 19 _____

S. J. LEWIS
Scout

O.W.W.O.

County Barton State Kansas

Sec. 31 (Blk. Twp.) 20 (Sur. Rge.) 13W Map No.

Operator W. L. Graham

Well No. 1 Farm Hiss

Elev. 1901 Location NW NW NE

			o		

200 Ft. From N Line NE

200 Ft. From W Line Quarter

1st. Report OCT 20 1954

Completion

Remarks O.W.W.O.

Spudding Date O.W.W.O.

Drig. Data Hiss Pool

8" @ 147 Heeb. 3038 Br. line 3149

KC 3161 PreCamb. 3314 OTD 3315

perf/ 3252-56 114 bo 14 hr. C0 to 3306

perf/ 3303-06 1000 A S/ 1 1/2 boph

SP 3290 13/ 3283-88 1000 A S/ 8 boph

FABEN GILSTRAP

