

O. W. P. B. Adzwick
Adzwick

KANSAS

Form 51-5M-11-31-Palace

Map No. KANSAS Sec. *16* Twp. *25* R. *1E*


Well No. *#2-*

Farm

Smith
Continental Oil

Company

NORTH

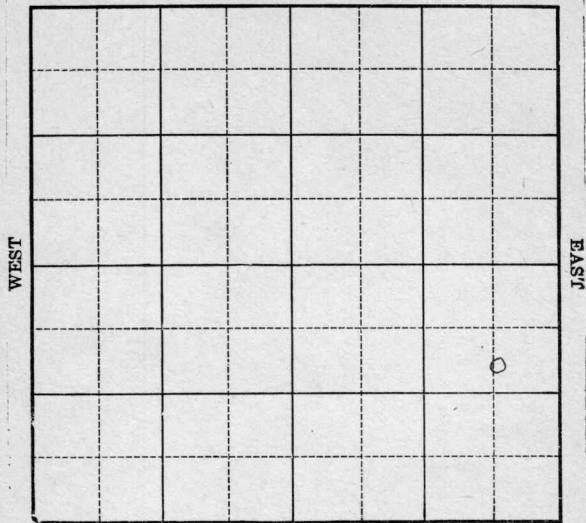

WEST

EAST

SOUTH

Location _____

Drilling Remarks _____

Rig Up _____

Drilling Remarks _____

RECORD

Cased _____ in. _____ ft.

Sand _____

Gas _____

Oil _____

Total Depth _____

PRODUCTION

1st 24 hrs. Nat. _____

1st 24 hrs. after shot _____

Gas _____ cu. ft.

Dry Hole _____

Abandoned _____

Map No. KANSAS Sec. 16 Twp. 25 R. 1E

Well No. #2-Smith Farm

Continental Oil Company

Goodrich Pool.


990 Ft. from N. Line

1650 Ft. from S. Line

648 Ft. from E. Line

Ft. from W. Line

1932

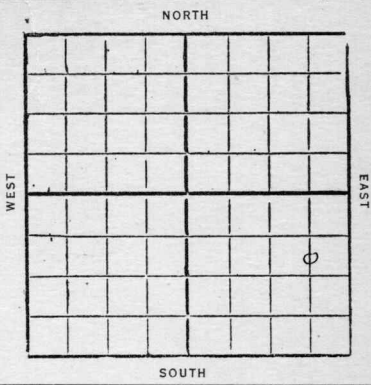

Date	REPORT
	<u>1447'</u>
8/17	<u>Log.</u>
8/24	<u>Rig</u>
8/31	<u>15"-238</u>
	<u>drlg 460'</u>
9/7	<u>12"-1310</u>
	<u>drlg 1600</u>
9/14	<u>10"-1956</u>
	<u>drlg 2455</u>
9/21	<u>show oil & water</u>
	<u>from 2605-10</u>
	<u>8"-2710</u>
	<u>Drlg 2860'</u>
9/30	<u>top chat 3002</u>
	<u>zulled in rig</u>
10/5	<u>6"-3006</u>
	<u>HFW 3045</u>
	<u>drlg 3115'</u>
10/12	<u>show oil 3040</u>
	<u>HFW 3045</u>
	<u>Base line 3270</u>
	<u>Drlg 3305</u>

OVER

10/19- Top Dolomite 3059
Base Miss line 3287
U/R 6"-3006

10/26- Cem 6"-3359'

11/2- Cased 6"-3359
Sand 3362-68
TD 3368
P.B. 3367

swab 100 bbl oil and
12 bbl water 24 hr

~~Comp~~
COMPLETED

1955

O. W. P. B.

~~OTD 3368'~~

8/10

OTD 3368' 6" @ 3359 CO to 3307
18/3002-08 FU 400' oil 15 min.
B/26 BO 6 hr. B/dry SI overnight
FU 200' wtr. CO 15/3020-26 B/4 BW
4 hrs. Frac PB 2942 3/2735-36
DC to 3307 36/2724-36 B/10 GM & wtr.
1000 A P/53 BO 134 BW 24 hrs.
Comp. 51 BOPD 134 BW
L. 2331' M. 3002' Hunton 3359'
TD 3368'

**FIRST REPORT
COMPLETED**

13 KANSAS

Seay Nick

E

Map No. Sec. 16 Twp. 25 R. 1

Well No. 2 Smith

Continental Oil Co Company

Contractor

FIRST REPORTS

SECTION PLAT

990 Ft. from N. Line

Ft. from S. Line

648 Ft. from E. Line

Ft. from W. Line

			0

Location

Rig up

Drilling and Remarks:

R.O.Y.

RECORD

Cased in, ft.

Sand

Gas

Oil

Total Depth

PRODUCTION

1st 24 hrs. Nat.

1st 24 hrs. after shot

Gas Cu. Ft.

Dry Hole

Abandoned

Date

AUG 17 1932

192

CHAS. L. SHERWOOD

Scout

Deegnick

13 KANSAS

E

Map No. _____ Sec. *16* Twp. *25* R. *1*

Well No. *2* *Smith*

Continental Oil Co Company

Contractor

COMPLETED

SECTION PLAT

990 Ft. from N. Line

_____ Ft. from S. Line

648 Ft. from E. Line

_____ Ft. from W. Line

			o

Location _____

Rig up _____

Drilling and Remarks:

PB to 3367

*Swab 100 Bls Oil
12 Bls Water
24 Hours.*

RECORD

Cased *6* in., *3359* ft.

Sand *3362-3368*

Gas _____

Oil _____

Total Depth *3368*

PRODUCTION

1st 24 hrs. Nat. _____

1st 24 hrs. after shot _____

Gas _____ Cu. Ft.

Dry Hole _____

Abandoned _____

Date

NOV 2 1932

CHAS. L. SHERWOOD

192 Scout

O. W. P. B.

OWPB

FORM 513 REV. SUNRAY

County Sedgwick Elev. 1447
 Sec. 16 Twp. 25 Rgs. 1E
 Company Continental Oil
 Farm Name O. M. Smith No. 2

TOPS	DEPTH	LOG	DATUM	Loc. in Sec.
Anh.				SE NE SE
Tp.				
H.				1650' SL
Tr.				
Dg.				648' EL
Bl.				
L.	2331			Geol.
K.C.				
B.K.C.				Contr.
Ce.				
C.				Pool
M.	3002			
M. <u>Hunton</u>	3359			Goodrich
K.				
Mz.				<div style="border: 1px dashed black; padding: 5px; text-align: center;"> <p>FIRST REPORT AUG 10 '55 COMPLETE</p> </div>
Ma.				
V.				
S.				
S.				
A.				
R.				
PC.				
G.				
T.D.	3368			

Date Comm. OTD 3368, 6" @ 3359 CO to 3307
18/ 3002-08 FU 400' oil 15 min.
B/ 26 bo 6 hr, B/ dry SI overnite
FU 200' wtr. CO 15/ 3020-26
B/ 4 bw 4 ^{hr} min. frac PB 2942
3/ 2735-36 DC to 3307 36/ 2724-36
B/ 10 gm & wtr 1000 A P/ 53 bo
134 bw 24 hr. Comp. 51 bopd 134 bw