

Barton

KANSAS

Section 17 Township 20 Range 14 W

Well No. # 1 Smith

Company Kansas- Nebraska

NORTH

0							

WEST

EAST

SOUTH

Barton

KANSAS

Sec. 17 Twp. 20 R. 14 W

Well No. # 1 Smith Farm

Kansas-Nebraska Company

Contractor


Ft. from N. Line

630 Ft. from S. Line

Ft. from E. Line

330 Ft. from W. Line

W/2 SW NW

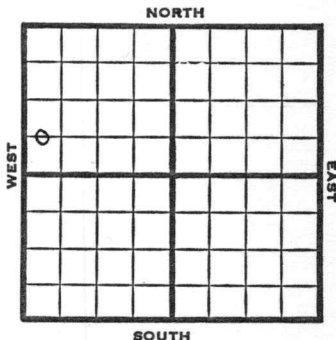

1951

Elev. 1904'

REPORT

6/27

Location

8/1

Spud 7-6-51
 D&A TD 3617
 Anhy 845
 8" @ 855
 KC 3301 Arb. 3591-3617 TD
 D&A

ABANDONED

County Barton State Kansas

Sec. 17 (Blk. 20 (Sur. 14W Map No. (Twp.) (Rge.))

Operator Kansas - Nebraska

Well No. 1 Farm Smith

Elev. 1904 Location C W L SW NW

630 Ft. From S Line NW

330 Ft. From W Line Quarter

Ist. Report

Completion AUG 1 1951

Remarks

Spudding Date 7-6-51

Drlg. Data D & A TD 3617

Anhy 845 8" @ 855 KC 3301 Arb. 3591-
3617 TD

D & A

J. E. TYRA

County Barton State Kansas

Sec. 17 (Blk. 20 (Sur. 14W Map No.

Operator Kansas - Nebraska

Well No. 1 Farm Smith

Elev. _____ Location W/2 SW NW

FIRST REPORT									
0									

630 Ft. From S Line NW

330 Ft. From W Line Quarter

1st. Report JUN 27 1951

Completion _____

Remarks _____

Spudding Date _____

Drlg. Data _____

Location _____