

KANSAS


Pawnee

Form 51—5M—7-40—Palace

Section 13 Township 20 Range 16-W

Well No. #2 Gates

Company Stanolind et al

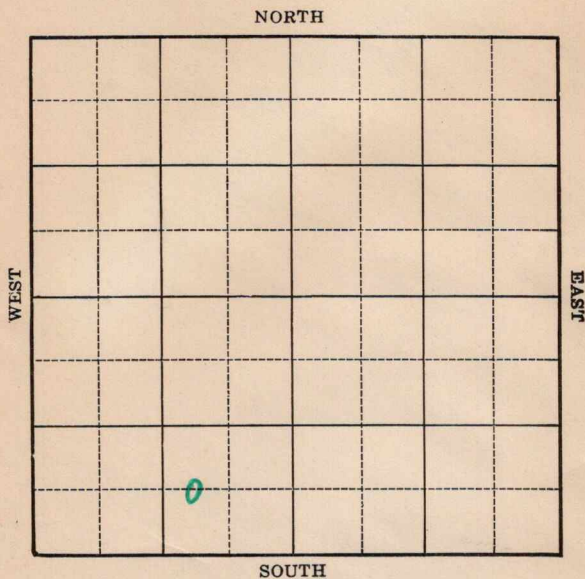

O.W.P.B.

752226
752230

3/26--Top Arbuckle 3795 (Corrected)

T.D. 3859 (Corrected)

Cemented 5" 3859 (Corrected)

Drilled plug to T.D. 3854 $\frac{1}{2}$

Perforated 13 holes 3845-50 $\frac{1}{2}$

Filled up 150 feet oil in 1 hour

" " 750 " " " 3 hours

Acidized 500 gallons

Flowing 18 bbls. per hour by heads (Tel)

Running 58' higher on Arbuckle than our #1 Bixby
NW/c Sec. 24 completed for 252 bbls.

Running 46' higher on Arbuckle than Simpson
#1 Gates SW/c Sec. 23 completed for 257 bbls

4/1--Shot 10 shots 3845-47 500 gallons acid

Flowed 59 bbls. 1st hour

" 39 " 2nd "

" 38 " 3rd "

" 39 " 4th "

Still testing (Tel)

4/3--Tried to take a bomb potential

Not enough gas

Reacidizing upper perforations

(3845 $\frac{1}{2}$ -50 $\frac{1}{2}$) with 1000 gallons today

4/4--Acidized 1000 gallons

Flowed 16 $\frac{1}{4}$ bbls. in 2 hrs. by heads

Will perforate a little higher to
get more gas to take bomb potential

4/7--Waiting on tanks Trucking oil out

Will reperforate (Tel)

4/14--Perforated 14 shots 3834-41

500 acid Flow 25 bbls. per hour
thru 2 $\frac{1}{2}$ " tubing Will take

potential as soon as they get
tanks up (Tel)

4/18--Perf. 4 shots 3841-42
" 4 " 3838-39
" 4 " 3837 $\frac{1}{2}$ -39
" 2 " 3834-35

500 acid at 3834-35

Flow 25 bbls. per hr. 2" tubing choke
3/8 open

4/18--Waiting on state potential (Tel)

4/19--Hauling oil out so they can take potential

4/21-- " " " " " " " "

4/25--Have not taken potential yet (Tel)

5/1--Waiting orders Will take potential (Tel)

5/3--Will take potential Monday (Tel)

5/8 " " "

5/9--Tanks full Will take pumping potential
next week (Tel)

5/15 " " "

5/16--Have not taken a state potential yet
Temporary potential 672 bbls.
Allowable 612 bbls. for May (Tel)

5/22 " " " "

5/26--Will take pumping test today (Tel)

5/27--Flowing potential 951 bbls. oil plus
26 bbls. water (Tel)

OVER

1941
5/27

Arb. 3795'

5" - 3859'

T.D. 3859'

10 shots 3845-47'

14 " 3834-42'

2000 acid.

Cement drilled to 3854½'

Flow 95l oil & 26 water

38. Gravity

COMPLETED

1941

O. W. P. B.

7/16

Old T.D. 3854'

P.B. to 3823' & SD.

7/24

" " "

7/31

36 shots 3843-48' 500 acid. Water.

24 shots 3837-41' 1000 acid.

Flow 95 bbls. fluid 1 hour.

8/7 Shut down.

8/15

" "

8/20

Arb. 3801'

T.D. 3854'

P.B. to 3823'

Drilled to 3850'

1500 acid.

24 shots 3837-41'

Old potential 95l bbls.

COMPLETED

Map No. 81 Sec. 13 Twp. 20 R. 16WWell No. 2 GatesStanolind etal

Company

FIRST REPORT

Contractor

SECTION PLAT

C W L SE SW

 Ft. from N. Line660 Ft. from S. Line990 Ft. from E. Line Ft. from W. Line

PAWNEE ROCK POOL

	0		

Location XRig up

Drilling and Remarks:

*Special***OFFSET**

RECORD

Cased in., ft.Sand Gas Oil Total Depth

PRODUCTION

1st 24 hrs. Nat. 1st 24 hrs. after shot Gas Cu. Ft.Dry Hole Abandoned

Date

FEB 5 1941 19S. J. LEWIS Scout

Map No. 81 Sec. 13 Twp. 20 R. 16WWell No. 2 GatesStanolind

Company

COMPLETED

Contractor

C W L SE SW

SECTION PLAT

	0		

 Ft. from N. Line660 Ft. from S. Line990 Ft. from E. Line Ft. from W. Line

PAWNEE ROCK POOL

Location

RECORD

Cased in., ft.Sand Gas Oil Total Depth 3859

PRODUCTION

1st 24 hrs. Nat. 1st 24 hrs. after shot Gas Cu. Ft.Dry Hole Abandoned

Drilling and Remarks:

Cr 837955" @ 385910 Sh to 3845-4714 " 3884-422000 acidFlow 95 oil 26 waterPer 382 Gr.Cement & Drill bit to 3854 1/2

Date

MAY 27 1941

19

S. J. LEWIS Scout

Map No. 81 Sec. 13 Twp. 20 R. 16WWell No. 2 GatesStanolind Company~~CORRECTION~~ Contractor

C W L SE SW

 Ft. from N. Line660 Ft. from S. Line990 Ft. from E. Line Ft. from W. Line

PAWNEE ROCK POOL

SECTION PLAT

	0		

Location Rig up

Drilling and Remarks:

OWDD - P.B.

OTD 3854

Plugged back
3823 and SD

RECORD

Cased in., ft.Sand Gas Oil Total Depth

PRODUCTION

1st 24 hrs. Nat. 1st 24 hrs. after shot Gas Cu. Ft.Dry Hole Abandoned

Date

JUL 16 1941 19S. J. LEWIS Scout

Map No. 81 Sec. 13 Twp. 20 R. 16WWell No. 2 GatesStanolind CompanyCOMPLETED Contractor

SECTION PLAT

C W L SE SW

 Ft. from N. Line660 Ft. from S. Line990 Ft. from E. Line Ft. from W. Line

PAWNEE ROCK POOL

	0		

Location Rig up

Drilling and Remarks:

*Ac 3801**PB 3823**Dul'col to 3550**1500 acid**24 shot to 3837-41**Old Bx 951*

RECORD

Cased in., ft.Sand Gas Oil Total Depth 3834

PRODUCTION

1st 24 hrs. Nat. 1st 24 hrs. after shot Gas Cu. Ft.Dry Hole Abandoned

Date

AUG 20 194119S. J. LEWISScout