


Section 16 Township 25 Range 1-E

Well Number 1- Smith "A"

Company Prunty Production

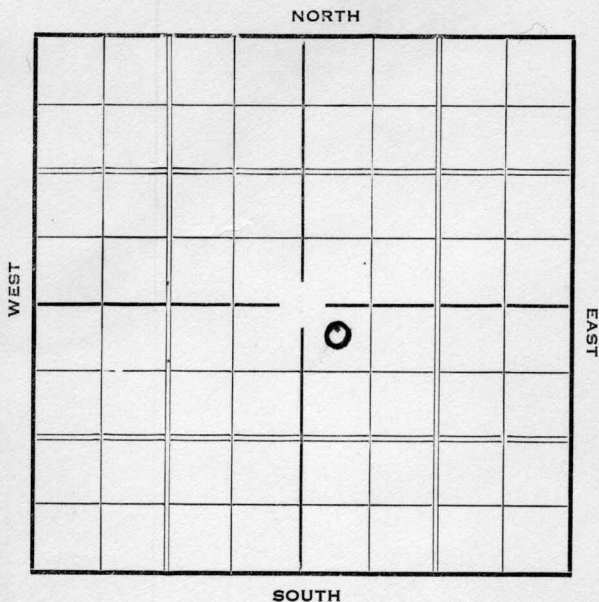

Sec. 16 Twp. 25 R. 1-E

Well No. #1 Smith "A" Farm

Prunty Production Company


330 Ft. from N. Line

\_\_\_\_\_ Ft. from S. Line

\_\_\_\_\_ Ft. from E. Line

330 Ft. from W. Line

Elev. 1438

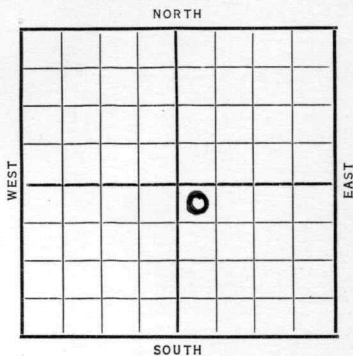

Date

REPORT

1937

5/26

Drlg. 1170' Rotary.

6/4

10" @ 198'. Drlg. 2920'.

6/11

Misner 3341-43'.

Dolomite 2920'.

T.D. 3343'. 7" @ 3341'.

RUST.

6/19

" " " "

6/25

250' oil.

7/2

T.D. 3344'. Swab 73 oil & 50 water 24 hrs.

7/7

7" @ 3341'.

Misner Dolo 3341'.

T.D. 3344'.

2000 A.

Pot. 580 oil & 360 water.

COMPLETED

**KANSAS**

*Sedgwick*

Map No. 13 Sec. 16 Twp. 25 R. 1E

Well No. 1 - Smith "A"

Prunty Production Company

Contractor

**FIRST REPORT**

**SECTION PLAT**

330 Ft. from N. Line

\_\_\_\_\_ Ft. from S. Line

\_\_\_\_\_ Ft. from E. Line

330 Ft. from W. Line

		0	

*(Continental farm-out on 20-A strip)*

Location \_\_\_\_\_

Rig up \_\_\_\_\_

Drilling and Remarks:

*Alg 1170*

*Rotary*

**RECORD**

Cased \_\_\_\_\_ in., \_\_\_\_\_ ft.

Sand \_\_\_\_\_

Gas \_\_\_\_\_

Oil \_\_\_\_\_

Total Depth \_\_\_\_\_

**PRODUCTION**

1st 24 hrs. Nat. \_\_\_\_\_

1st 24 hrs. after shot \_\_\_\_\_

Gas \_\_\_\_\_ Cu. Ft.

Dry Hole \_\_\_\_\_

Abandoned \_\_\_\_\_

Date

MAY 26 1931

H. D. Hatfield Scout

Sedgwick

Map No. 13 Sec. 16 Twp. 25 R. 1 E

Well No. 1-Smith "A"

Prunty Prod. Company

Contractor

COMPLETED

SECTION PLAT

330 Ft. from N. Line  
     Ft. from S. Line  
     Ft. from E. Line  
330 Ft. from W. Line

		0	

Location \_\_\_\_\_

Rig up \_\_\_\_\_

Drilling and Remarks:

2000 A

Pat - 580 oil  
360 wat

RECORD

Cased 7 in., 3341 ft.  
~~Sand~~ Misner Dolo - 3341  
Gas \_\_\_\_\_  
Oil \_\_\_\_\_  
Total Depth 3344

PRODUCTION

1st 24 hrs. Nat. \_\_\_\_\_  
1st 24 hrs. after shot \_\_\_\_\_  
Gas \_\_\_\_\_ Cu. Ft.  
Dry Hole \_\_\_\_\_  
Abandoned \_\_\_\_\_

Date

JUL 7 1937 19

H. D. Hatfield

Scout