

Barton

KANSAS

13

20S

14W


SECTION _____ TOWNSHIP _____ RANGE _____

#1 Titus

WELL NO. _____

Leben Drlg. & R.S.C.

COMPANY _____

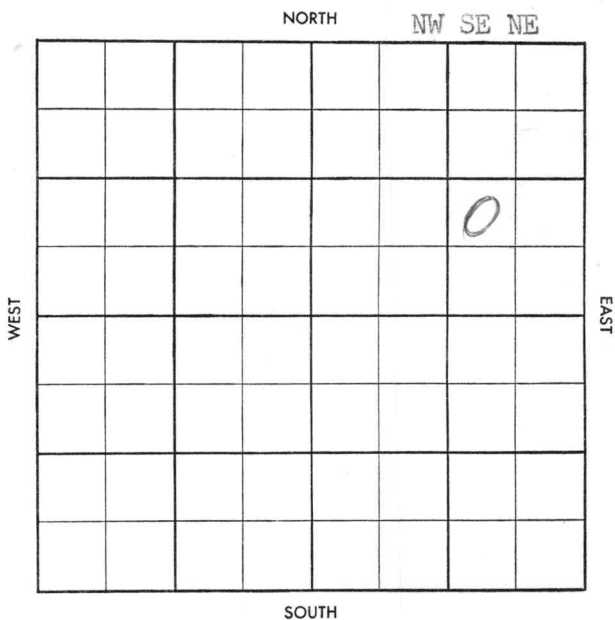

Twp. ~~X~~ Pool ~~X~~
~~X~~ O.W.W.O. ~~X~~
 Co. ~~X~~ Facet ~~X~~

S-513-B

County Barton Elev. 1886 DF
 Sec. 13 Twp. 20 Rge. 14W
 Company Leben Drlg.
 Farm Name Titus No. 1

TOPS	DEPTH	LOG	DATUM
Anh.			
Tp.			
H.			
Tr.			
Dg.			
B.L.			
L. <u>K</u>	<u>3248</u>		
K.C.			
B.K.C.	<u>3467</u>		
Ce.			
C.			
M.			
M.			
K.			
Mz.			
Mq.			
V.			
S.			
S.			
A.	<u>3504</u>		
R.			
Pf.			
G.			
<u>OTD</u>	<u>3602</u>		
T.D.			

Loc. in Sec. _____
NW SE NE
(O.W.W.O.)
 Geol. O.W.W.O
 Contr. _____
 Pool _____

Harrison
(Un-pro)


Date Comm. OLD INFO: Tops. 5" @ 3601, LK
well perfs 3427-32 Comp. Jan., 1958.
NEW INFO: MICT CO PB 3412 28/3389 $\frac{1}{2}$ 96, 3 $\frac{1}{2}$
BOPH, Nat. 3500/A, Swb 1d, Swb 3 $\frac{1}{2}$ BOPH, POP,
P 43 BO, NW 24 hrs, Dec to 15 BOPD 6-28-58,
MICT, Sq 3389-96 Cem. Commun & Sq 3427-32, CO
Plug @ 3412, set plug 3450, Re-perf 20/3427-
32, CO Plug @ 3412, set plug 3450, Re-perf
20/3427-32, 3000A, 25 BWPB, PB 3410, 20/3390-

95, Swb 25 BWPB 1500' O.B., PB 3385, 20/3371-
76, Swb 25 BWPB 1000' O.B., (w/SG & O), 3000A,
@ 3371-76, Swb 1d, Swb averg. 19 BOPB NW/7
hrs., POP P averg. 17 BOPB/7 hrs, NW P 66 BO/
21 hrs, NW P 70 BO/24 hrs NW COMPLETE
LK perfs 3371-76, PB 3385, OTD ~~5602.~~