
Sedgwick

Form 51—5M—11-31—Palace

Map No. KANSAS Sec. 17 Twp. 25 R. 1E

Well No. 1 Steurns Farm

Steurns et al Company

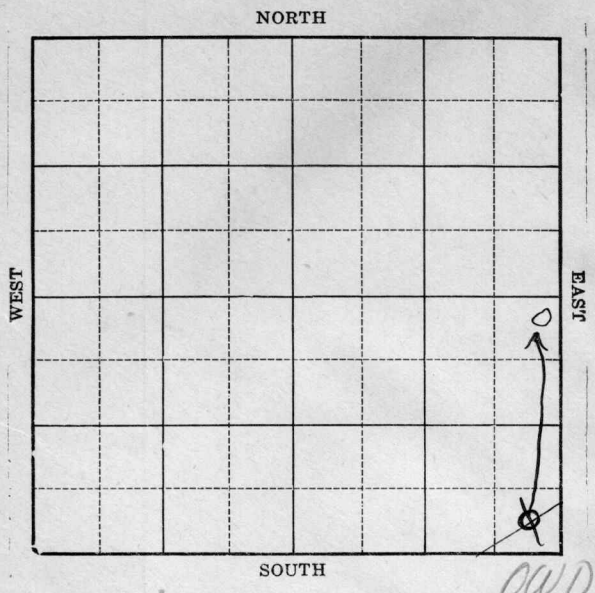

OWDD

Location

Drilling Remarks

Rig Up

Drilling Remarks

RECORD

Cased in. ft.

Sand

Gas

Oil

Total Depth

PRODUCTION

1st 24 hrs. Nat.

1st 24 hrs. after shot

Gas cu. ft.

Dry Hole

Abandoned

Form 252-A
5M 4-32 MPC

Sedgwick

Map No. KANSAS Sec. 17 Twp 25 R. 1E

Well No. 1 Stearns Farm


Stearns et al Company

330 Ft. from N. Line

~~330~~ Ft. from S. Line

330 Ft. from E. Line

Ft. from W. Line

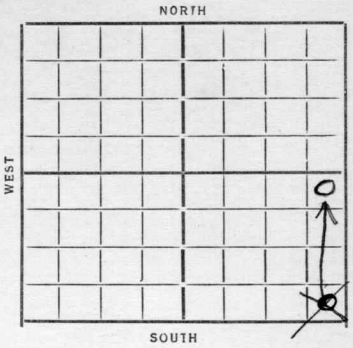

Date 1934	REPORT (OWDD)
4/25	Location
5/3	Material
5/10	— 5/18 — 5/25 —
5/31	— 6/7 — 6/14 —
6/21	Bldg. Rig
6/28	—
7/5	Rigg up
7/12	Dlg 835 15" 769
7/19	" 1185
7/26	" 1685
8/2	" 2135
8/9	" 2630 S.O. 2600
8/16	B.K.C. Lime 2774 2976 WR6"
8/23	8" 2953 T Chat 2996
	6" Lime 3003 S.O. 3003-09
	HFW 3015-20 Dlg.
8/30	8" 3038 Dlg 3050
9/6	HFW 3067 6" 3235 Dlg 3253
9/13	B. Lime 3257 Meisner 3331
	Hunton 3332 TD 3337
	2700' oil 16 hrs. Running rods & tubing

— OVER —

9/19 Huntow 3332
TD 3337
Pot 219 oil 42 water

COMPLETED

1934 OWDD

12/12 Oly 3368

12/21 B. Huntow 3354
Viola 3377
HFW 3381-83

12/27 Simpson 3400
Oly 3418

1/3/35 3439 NR 5"

1/10 Oly 3439

1/17 Oly 3481 HFW 5" 3441

1/24 Silicous 3480 TD 3495
PB RCL

1/31 PB 2621 NR 6"

2/7 PB 2614 acidizing

2/14 —

2/20 Silicous 3480
TD 3495 IPA

ABANDONED

Form 26—1M Bks.—2-29

Kingsbury KANSAS

Map No. 13 Sec. 17 Twp. 25 R. 16

Well No. 1 — Stearns

Stearns etal Company

Contractor

FIRST REPORTS


____ Ft. from N. Line

330 Ft. from S. Line

330 Ft. from E. Line

____ Ft. from W. Line

SECTION PLAT

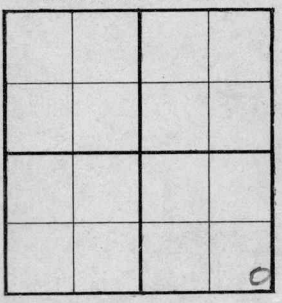

Location ____

Rig up ____

Drilling and Remarks:

RECORD

Cased ____ in., ____ ft.

Sand ____

Gas ____

Oil ____

Total Depth ____

PRODUCTION

1st 24 hrs. Nat. ____

1st 24 hrs. after shot ____

Gas ____ Cu. Ft.

Dry Hole ____

Abandoned ____

Date

4-25-34 19

ORVAL MANNSCHRECK Scout

Form 26—1M Bks.—2-29

Kaipaick

Map No. 13 Sec. 17 Twp. 25 R. 1 E

Well No. 1— Stearns

Stearns etal Company

Contractor

CORRECTION


330 Ft. from N. Line

Ft. from S. Line

330 Ft. from E. Line

Ft. from W. Line

SECTION PLAT

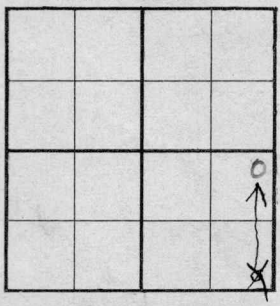

Location

Rig up

Drilling and Remarks:

moved ½ mile north. formerly reported in NEC

RECORD

Cased in., ft.

Sand

Gas

Oil

Total Depth

PRODUCTION

1st 24 hrs. Nat.

1st 24 hrs. after shot

Gas Cu. Ft.

Dry Hole

Abandoned

Date

6-13-37 19

ORVAL MANNSCHRECK Scout

Form 26—1M Bks.—9-28

Kingswick KANSAS

Map No. 13 Sec. 17 Twp. 25 R. 12E


Well No. 1- Stearns

Stearns etal Company

Contractor

COMPLETED

SECTION PLAT

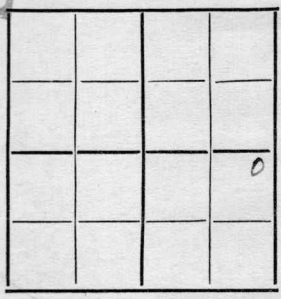

330 Ft. from N. Line

Ft. from S. Line

330 Ft. from E. Line

Ft. from W. Line

Location

Rig up

Drilling and Remarks:

pot. 219 oil
42 water

RECORD

Cased in., ft.

Sand Hunton 3332

Gas

Oil

Total Depth 3337

PRODUCTION

1st 24 hrs. Nat.

1st 24 hrs. after shot

Gas Cu. Ft.

Dry Hole

Abandoned

Date

9-19-37 192

ORVAL MANNSCHRECK Scout

Form 26—1M Bks 9-28

KANSAS

Map No. 13 Sec. 17 Twp. 25 R. 12

Well No. 1— Stearns

Stearns etal Company

Contractor

FIRST REPORT


330 Ft. from N. Line

Ft. from S. Line

330 Ft. from E. Line

Ft. from W. Line

SECTION PLAT

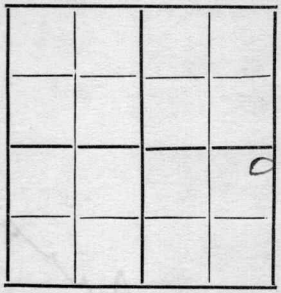

CWDW

Location

Rig up

Drilling and Remarks:

OTD 3337

Dep 3368

RECORD

Cased in., ft.

Sand

Gas

Oil

Total Depth

PRODUCTION

1st 24 hrs. Nat.

1st 24 hrs. after shot

Gas Cu. Ft.

Dry Hole

Abandoned

Date

12-12-37 192

ORVAL MANNSCHRECK Scout

Form 26—1M Bks—9-28

KANSAS

Barnes

Map No. 13 Sec. 17 Twp. 25 R. 12E

Well No. 1— Stearns

Stearns etal Company

Contractor

ABANDONED


330 Ft. from N. Line

Ft. from S. Line

330 Ft. from E. Line

Ft. from W. Line

SECTION PLAT

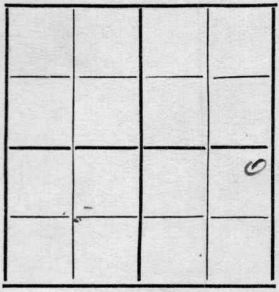

Location

Rig up

Drilling and Remarks:

10 T F1

RECORD

Cased in., ft.

Sand Siliceous 3480

Gas

Oil

Total Depth 3495

PRODUCTION

1st 24 hrs. Nat.

1st 24 hrs. after shot

Gas Cu. Ft.

Dry Hole

Abandoned

Date

ORVAL MANNSCHRECK

2-20-35 192.... Scout