


Barton

Section 11 Township 20 Range 14W

Well No. #1 Bradley

Company Schermerhorn Oil Company

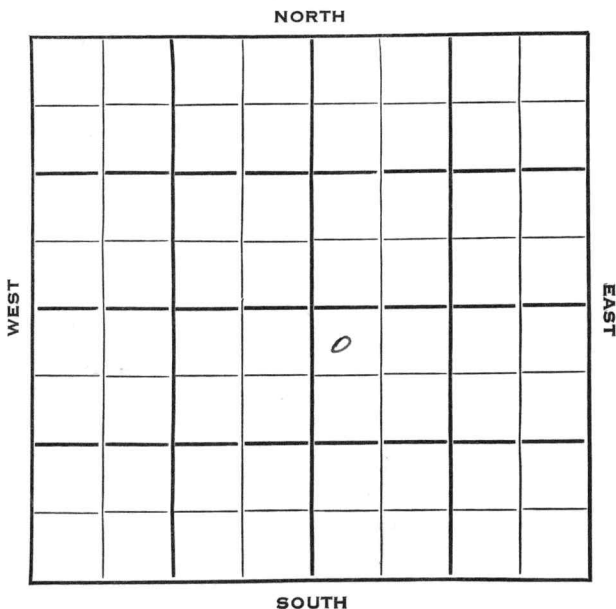

Barton
20

KANSAS
14W

Sec. 11 Twp. R.

Well No. #1 Bradley Farm

Schermerhorn Oil Company

Badger Contractor
Wildcat


330 Ft. from N. Line

Ft. from S. Line

Ft. from E. Line

330 Ft. from W. Line

NW NW SE

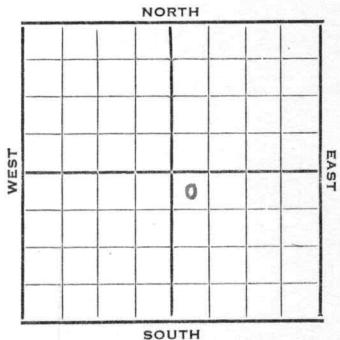


1953 Elev. 1878' REPORT

2/18 Spud 2-10-53
MIR
Anhy 794
8" @ 795
Drlg. 2010'

2/25 Spud 2-10-53
D&A
TD 3575
Anhy 794
8" @ 795
Heeb 3124, Tor 3143, Doug 3156,
Br lime 3227, ans 3239, Arb 3540
TD 3575
DST 3240-54, opn 25 mins., rec.
15' mud
DST 3258-3308, opn 1/2 hrs., rec.
15' mud
DST 3389-3413, opn 25 mins., rec.
15' mud
D&A

ABANDONED

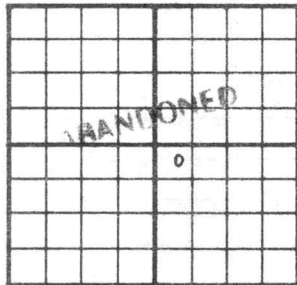County Barton State KansasSec. 11 (Blk.
Twp.) 20 (Sur.
Rge.) 14W Map No. _____Operator Schermerhorn OilWell No. 1 Farm BradleyElev. 1878 Location NW NW SE330 Ft. From N Line SE330 Ft. From W Line Quarter1st. ReportCompletion FEB 25 1953Remarks WildcatBadger - Contr.Spudding Date 2-10-53Drig. Data D & A TD 3575Anhy 794 8" @ 795 Heeb. 3124Tor. 3143 Doug. 3156 Br. lime 3227Lans. 3239 Arb. 3540 TD 3575DST 3240-54 open 25 min. Rec. 15' mudDST 3258-3308 open $\frac{1}{2}$ hr. Rec. 15' mudDST 3389-3413 open 25 min. Rec. 15' mudD & A