


Sedgwick

KANSAS

Section 16 Township 25 Range 1-E

Well No. 2 - Smith "A"

Company Prunty Prod.

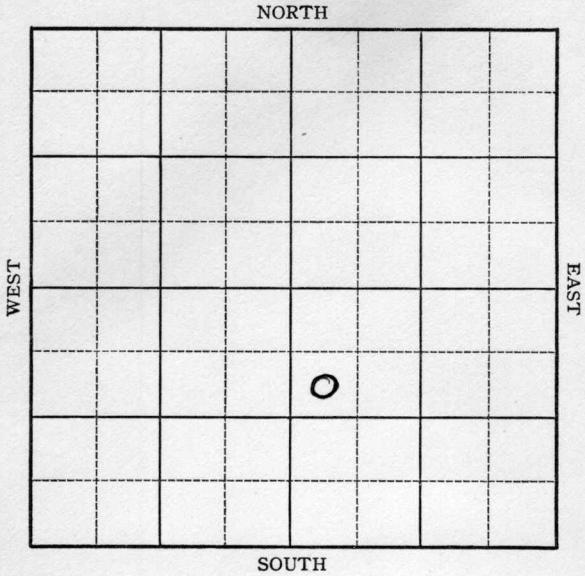

Sec. 16 Twp. 25 R. 1-E

Well No. #2 Smith "A" Farm

Prunty Prod. Company


990 Ft. from N. Line

_____ Ft. from S. Line

_____ Ft. from E. Line

330 Ft. from W. Line

Elev. 1440

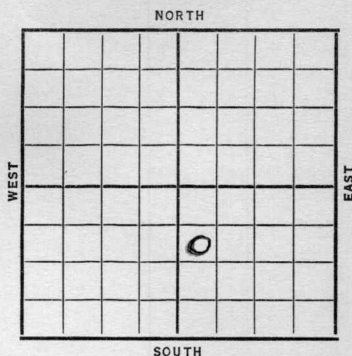

Date	REPORT
1937	
9/15	B.R.R.
9/24	10" @ 193'. Drlg. 913'.
10/2	Drlg. 2695'.
10/8	Chat 2992'. Drlg. 3257'.
	No shows.
10/15	Misner 3347'. 7" @ 3348'. WOC.
	No shows reported.
10/20	7" @ 3348'.
	Misner 3347'.
	T.D. 3355'.
	3000 acid.
	Pump 89.86 bbls. 4 hrs &
	95.4 bbls. 4 hrs.
	Potential 539 bbls. oil &
	560 bbls. water.
	COMPLETED

Sedgwick

KANSAS

Map No. 13 Sec. 16 Twp. 25 R. 1E

Well No. 2-Smith "A"

Prunty Prod. Company

Contractor

FIRST REPORT

SECTION PLAT

		0	

990 Ft. from N. Line

_____ Ft. from S. Line

_____ Ft. from E. Line

330 Ft. from W. Line

Location _____

Rig up _____

Drilling and Remarks:

B.R.R.

RECORD

Cased _____ in., _____ ft.

Sand _____

Gas _____

Oil _____

Total Depth _____

PRODUCTION

1st 24 hrs. Nat. _____

1st 24 hrs. after shot _____

Gas _____ Cu. Ft.

Dry Hole _____

Abandoned _____

Date

SEP 15 1937 19

H. D. Hatfield

Scout

Sedgwick **KANSAS**

Map No. 13 Sec. 16 Twp. 25 R. 1E

Well No. 2 Smith "A"

Prunty Production Company

Contractor

COMPLETED

SW NW SE

990 Ft. from N. Line

_____ Ft. from S. Line

_____ Ft. from E. Line

330 Ft. from W. Line

SECTION PLAT

		0	

Location _____

Rig up _____

Drilling and Remarks:

3000 Acid

P- 89.86/4 95.4/4

*POT- 539 oil
560 water*

RECORD

Cased 7 in., 3348 ft.

Sand Misner 3347

Gas _____

Oil _____

Total Depth 3355

PRODUCTION

1st 24 hrs. Nat. _____

1st 24 hrs. after shot _____

Gas _____ Cu. Ft.

Dry Hole _____

Abandoned _____

Date

OCT 20 1937

19

H. D. Hatfield

Scout