


Sedgwick

Section 16 Township 25 Range 1-E

Well No. #3 Smith "A"

Company Prunty Prod.

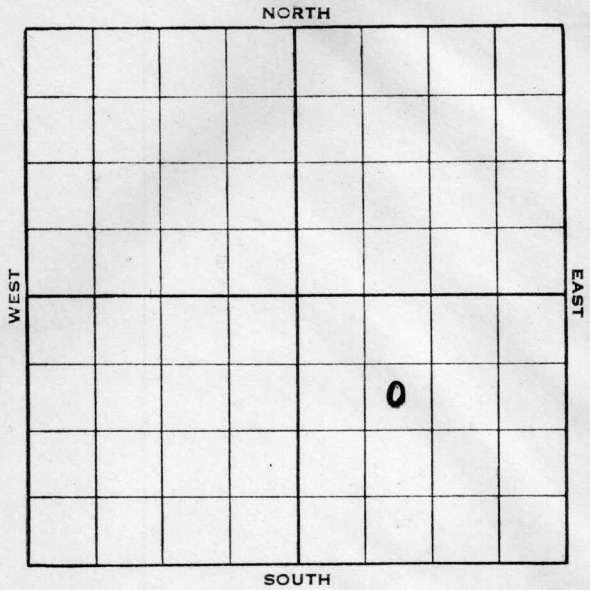

Sec. 16 Twp. 25 R. 1-E

Well No. #3 Smith "A" Farm


Prunty Prod. Company

990 Ft. from N. Line

_____ Ft. from S. Line

_____ Ft. from E. Line

990 Ft. from W. Line

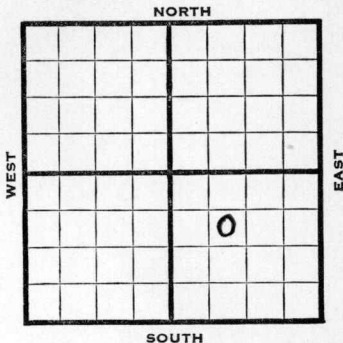

Elev. 1445

1938	REPORT
5/10	10" @ 182'.
	SD 2338' Rep.
5/20	" " "
5/27	Drlg. 3072'.
6/3	Misner Dolo. 3347'.
	T.D. 3349'. 7" @ 3347'. RUST.
6/10	Drilled plug. 400' oil in 10 hrs. 1500 acid.
6/15	7" @ 3347'.
	Misner 3347'.
	T.D. 3349'.
	1500 acid.
	Potential 473 bbls.
	COMPLETED

Map No. 13 Sec. 16 Twp. 25 R. 1E

Well No. 3 Smith "A"

Prumty Prod. Company

Contractor

FIRST REPORT

SECTION PLAT

SE NW SE

990 Ft. from N. Line

_____ Ft. from S. Line

_____ Ft. from E. Line

990 Ft. from W. Line

		0	

Location _____

Rig up _____

Drilling and Remarks:

10" - 182

SD 2338 Rep.

RECORD

Cased _____ in., _____ ft.

Sand _____

Gas _____

Oil _____

Total Depth _____

PRODUCTION

1st 24 hrs. Nat. _____

1st 24 hrs. after shot _____

Gas _____ Cu. Ft.

Dry Hole _____

Abandoned _____

Date

MAY 10 1938 19

H. D. Hatfield Scout

Map No. 13 Sec. 16 Twp. 25 R. 1E

Well No. 3 Smith "A"

Prunty Prod. Company

Contractor

COMPLETED

SE NW SE

990 Ft. from N. Line

_____ Ft. from S. Line

_____ Ft. from E. Line

990 Ft. from W. Line

SECTION PLAT

		0	

Location _____

Rig up _____

Drilling and Remarks:

1500 Acid

POT 473

RECORD

Cased 7 in., 3347 ft.

Sand Misener 3347

Gas _____

Oil _____

Total Depth 3349

PRODUCTION

1st 24 hrs. Nat. _____

1st 24 hrs. after shot _____

Gas _____ Cu. Ft.

Dry Hole _____

Abandoned _____

Date

JUN 15 1938

19

H. D. Hatfield

Scout