

KANSAS

Pawnee


FORM 51 5M 10-41 PETROL

Section 13 Township 20 Range 16-W

Well No. #2 Smith "B"

Company Amerada et al

NORTH Pawnee Pool

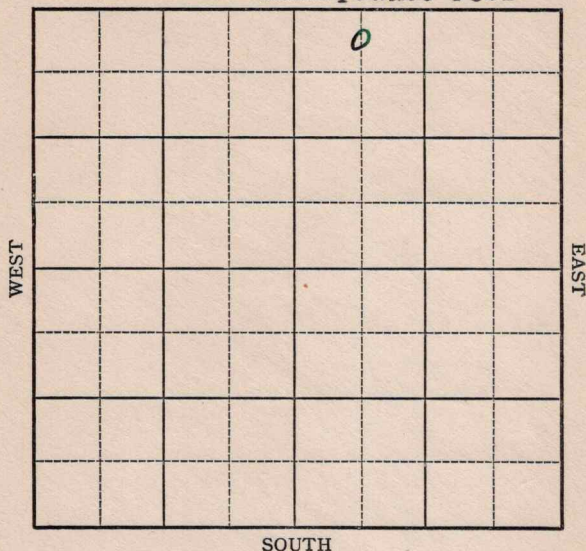

KANSAS

Pawnee

Sec. 13 Twp. 20 R. 16-W

Well No. #2 Smith "B" Farm

Amerada etal.

Company

(Pawnee)


330 Ft. from N. Line

Ft. from S. Line

Ft. from E. Line

660 Ft. from W. Line

Elev. 2074

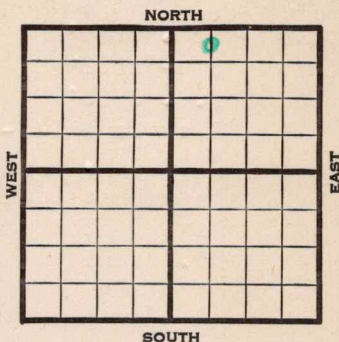

1941

REPORT

12/17

Location

12/24

"

12/31

723' run 8".

1942

1/8

8" - 713' Drlg. 1520'

1/15

Drlg. 3193'

1/22

Anhy 1083' Lans. 3476'

Arb. 3747' S.O. 5" - 3823' T.D.

RUST.

1/29

8" shots 3819-21' 500 acid.

Flow 188 oil & 46 water in 20 hours
thru 2" choke.

2/5

" " "

2/12

Squeezed perforations.

6 shots 3814 $\frac{1}{2}$ -16 $\frac{1}{2}$ ' 200 acid.

Flow 131 oil in 2 hours,

632,000 cu. ft. gas.

OVER

752261

1942

2/18

Arb. 3747'

5" - 3823'

T.D. 3823'

6 shots $3814\frac{1}{2}$ - $16\frac{1}{2}$ '

200 acid.

Bomb potential 7935 bbls.

Maximum 3000 bbls.

38. Gravity

COMPLETED

Map No. 81 Sec. 13 Twp. 20 R. 16WWell No. 2 Smith "B"Amerada etal. Company

Contractor

FIRST REPORT
C NL NW NE330 Ft. from N. Line Ft. from S. Line Ft. from E. Line660 Ft. from W. Line

SECTION PLAT

		o	

PAWNEE POOL

Location XXRig up

Drilling and Remarks:

RECORD

Cased in., ft.Sand Gas Oil Total Depth

PRODUCTION

1st 24 hrs. Nat. 1st 24 hrs. after shot Gas Cu. Ft.Dry Hole Abandoned

Date

DEC 17 1941 19S. J. LEWIS Scout

Map No. 21 Sec. 13 Twp. 20 R. 16WWell No. 2 Smith "B"Amerada etal. Company**COMPLETED**

Contractor

C NL NW NE

330 Ft. from N. Line Ft. from S. Line Ft. from E. Line660 Ft. from W. Line

SECTION PLAT

		0	

PAWNEE ROCK POOL

Location Rig up

Drilling and Remarks:

Cu & 37425" C 38236 shots to 38 14 1/2 - 16 1/2200 acidBone & P & 7935May 3000

RECORD

Cased in., ft.Sand Gas Oil Total Depth 3823

PRODUCTION

1st 24 hrs. Nat. 1st 24 hrs. after shot Gas Cu. Ft.Dry Hole Abandoned

Date

FEB 18 1942

19

S. J. LEWIS

Scout