


Barton

KANSAS

SECTION 13 TOWNSHIP 20 RANGE 14W

WELL NO. #1 Stolz

COMPANY Leben Oil & R.S.C.

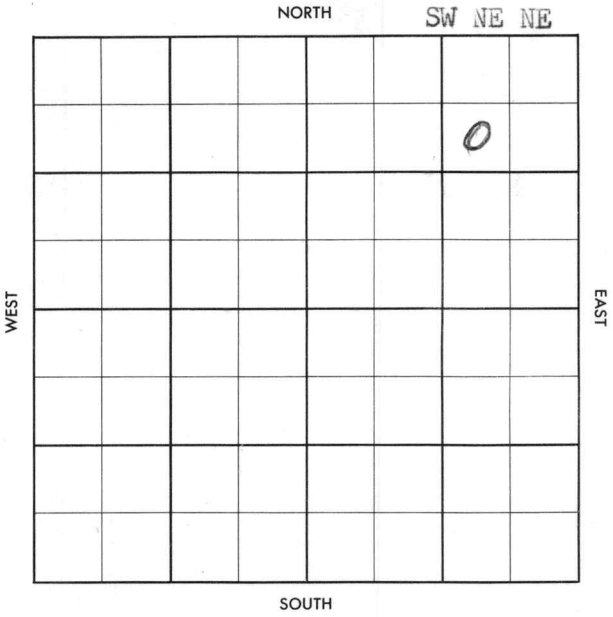

Barton

SEC. 13	TWP. 20 S	R. 14 W
------------	--------------	------------

WELL NO. # 1 Stolz FARM

COMPANY Leben Oil & R.S.C.


CONTRACTOR Leben Tools  
Wildcat

\_\_\_\_\_ FT. FROM N. LINE

\_\_\_\_\_ FT. FROM S. LINE

\_\_\_\_\_ FT. FROM E. LINE

\_\_\_\_\_ FT. FROM W. LINE

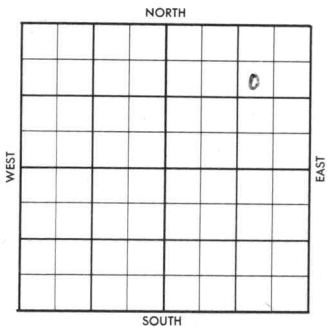

SW NE NE

SDX-3/4 Mile

ELEVATION

1957

REPORT

~~COMM. X 8-22~~

9/4

Comm. 8-23-57  
WORT

(FR Tkt)



✓ 13

Title

FORM 513 SUNRAY

County Barton Elev. 1889 KLB  
 Sec. 13 Twp. 20 Rge. 14W  
 Company Leben Oil & R.S.C.  
 Farm Name Stolz No. 1

TOPS	DEPTH	LOG	DATUM	Loc. in Sec.
Anh.				SW NE NE
TP.				
H.	3134			
Tr.	3150			
Dg.	3162			
BL.	3234			
L.	3243			
K.C.				Geol.
B.K.C.	3470			Concr.
Ce.				Leben Tools
C.	3478			Pool Harrison
M.				<del>Wildcat</del>
M.				
K.				
Mz.				
Mo.				
V.				
S.				
S.				
A.	3510			COMPLETE
R.				3/4 mile
PE.				DEC 11 '57
G.				
T.D.	3625			

Date Comm. 8-23-57  
 WORT 9-10-57 8 330/225  
 SEP 18 '57 DST 3246-54 1hr  
30' M BHP 0-400 ahead  
 SEP 25 '57 OCT 2 '57 OCT 9 '57 DST 3248-56 60"  
30' M BHP 400 DST 3327-38  
60" 45' M+W SSO BHP 1050  
DST 3390-98 60" G/25' rec  
660' oil BHP 1300-1000 FP  
250-300 DST 3400-08

1 1/2 hrs G/110" 620 oil BHP  
1475<sup>2</sup> FP 200 DST 3514-24

60" G/25" 160' GCM BHA110

DST 35 34-54 1 hr G/43"

270' oil BHP 1000 FP 180

5" 3624 CO 24/3587-92

PB 3585 24/3577-83 5B fld

Dh 1090 oil DB 3575 40/3563-73

590 + 59w ph PB 3560

24/3545-54 1390 ph  $\frac{1}{2}$  of

22BOPh 3 hrs NW POP

OCT 16 '57 OCT 23 '57 OCT 30 '57 NOV 6 '57 P 21BOPd

NW P 27BOPd NW

P 20BOPd NW 50 days

PB 3573 PKT 3559

$\frac{1}{2}$  thru tag well Ld \$ 1600

SW 1 hr POP P 8.35B0

tw 24 hrs P pulled PKT

NOV 13 '57 P10B0 325 BW 24 hrs

Pulled T&R PB 3540 24/3403-09

\$ 2BOPh - not A F10 260

130.9 hrs 193B new oil

T&R POP NOV 20 '57 P 83B0 13 hrs

270 BS P 133B0 890w 24 hrs

SD NOV 27 '57 DEC 4 '57 wo pot DEC 11 '57

P14P 14/1B0 + 6 90w

39,109

new zone revised harrison pool  
13-20-14w SW NW NW