KANSAS
FORM 51 5M 4-41 PETROL


Pawnee

Section 13 Township 20 Range 16-W

Well No. 3 Belt

Company Hall-Jordan

Pawnee Rock Pool

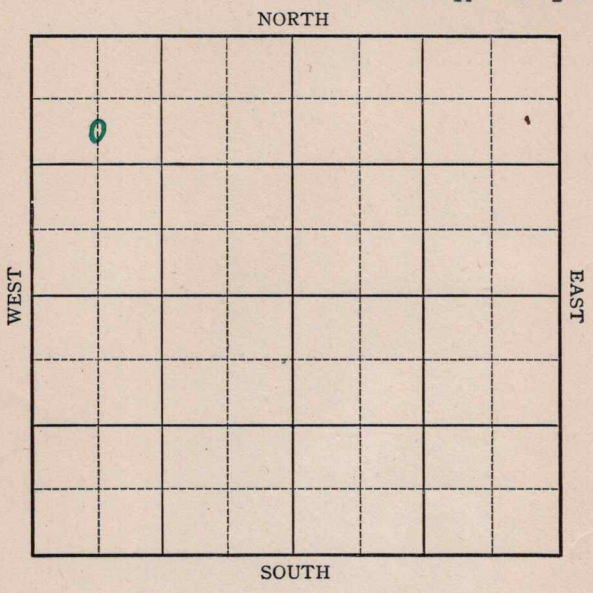

FORM 252-A 5M 6-41 PETROL KANSAS

Pawnee

Sec. 13 Twp. 20 R. 16-W

Well No. #3 Belt Farm

Hall-Jordan Company


(Pawnee Rock Pool)

990 Ft. from N. Line

_____ Ft. from S. Line

_____ Ft. from E. Line

660 Ft. from W. Line

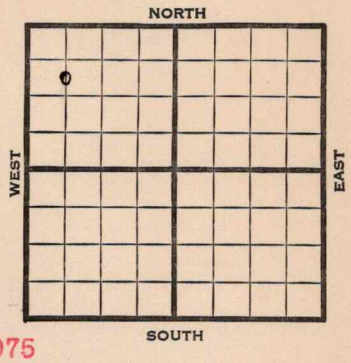

Elev. 2075

1941	REPORT
8/13	Skid in Roty Drk.
8/21	10" - 670' Drlg. 1410'
8/28	Anhy 1090' Drlg. 3370'
9/4	Arb. 3762-3837' T.D.
	5" - 3837' RUST.
9/11	Drilled to 3828' T.D.
	17 shots 3816-19'
	Flow 311 bbls. in 3 hours.
9/17	Arb. 3762'
	5" - 3837'
	T.D. 3837'
	17 shots 3816-19'
	Bomb potential 6636 bbls.
	Maximum 3000 bbls.
	38. Gravity
	COMPLETED

Form 26 200 Bks. 5-41 McW. KANSAS Pawnee

Map No. 81 Sec. 13 Twp. 20 R. 16W

Well No. 3 Belt

Hall-Jordan Company

FIRST REPORT Contractor

C S L NW NW

990 Ft. from N. Line


Ft. from S. Line

Ft. from E. Line

660 Ft. from W. Line

PAWNEE ROCK POOL

SECTION PLAT

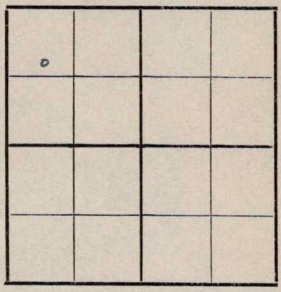

Location

Rig up

Drilling and Remarks:

Skid in Roty Der

RECORD

Cased in., ft.

Sand

Gas

Oil

Total Depth

PRODUCTION

1st 24 hrs. Nat.

1st 24 hrs. after shot

Gas Cu. Ft.

Dry Hole

Abandoned

Date

AUG 13 1941 19 S. J. LEWIS Scout

Form 26 200 Bks. 5-41 McW. Pawnee KANSAS

Map No. 81 Sec. 13 Twp. 20 R. 16W

Well No. 3 Belt

Hall-Jordan Company

COMPLETED Contractor

C S L NW NW

990 Ft. from N. Line


Ft. from S. Line

Ft. from E. Line

660 Ft. from W. Line

PAWNEE ROCK POOL

SECTION PLAT

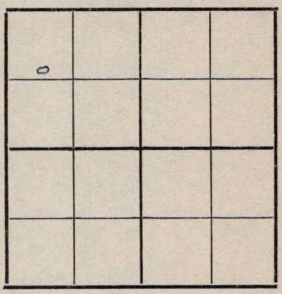

Location

Rig up

Drilling and Remarks:

Cir ✝ 3762
5' "0 3837
17 shots 3516-19
Bomb Pt ✝ 6636
Max 3000
38° Gr

RECORD

Cased in., ft.

Sand

Gas

Oil

Total Depth 3837

PRODUCTION

1st 24 hrs. Nat.

1st 24 hrs. after shot

Gas Cu. Ft.

Dry Hole

Abandoned

Date

SEP 17 1941 19 S. J. LEWIS Scout