

Section 13 Township 20 Range 14WWell No. #1 MosesCompany Petroleum Inc.

NORTH

		0					

SOUTH

WEST

EAST

Barton

KANSAS

SEC.	TWP.	R.
13	20	14W ✓

WELL NO.

#1 Moses

FARM

COMPANY

Petroleum Inc.

CONTRACTOR


Petroleum Inc.

330 Ft. from N. Line

Ft. from S. Line

990 Ft. from E. Line

Ft. from W. Line

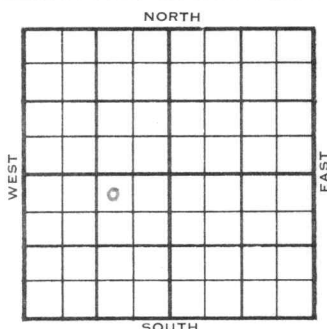

NW NE SW

	ELEVATION	REPORT
1953	1881'	
11/4	M I R	
11/11	8" @ 498' w/325 sks Drlg. 3200'	
11/18	Heeb 3140', Br li 3240', Lans 3253' DST 3295-3340', 1 hr., 240' Hlyocm, 600' froggy oil, 850# DST 3392-3426', 1 hr., 430' SW, 1090# Arb. 3542 TD 3550' 4½" @ 3450'	
1954 1/13	Soud 11-3-53 Oil well TD 3550' 8" @ 498 Heeb 3140 Br. lime 3240' Lans. 3253' DST 3295-3340 open 1 hr rec 240' HOCM 600' froggy oil 850# DST 3392-3426 open 1 hr rec 430' SW 1090# Arb. 3542' TD 3550' 4½" @ 3450 48/3322-34 1250 A S/3 BOPH Comp. 35 BOPD 35% wtr.	

COMPLETED

County Barton State Kansas

Sec. **13** (Blk. **20** (Sur. **14W** Map No.

Operator **Petroleum Inc.**

Well No. **1** Farm **Moses**

Elev.	Location	NW	NE	SW
-------	----------	----	----	----

[illegible]

330 Ft. From N Line SW

990 Ft. From **E** Line Quarter

1st. Report NOV 4 1953

Completion

Remarks

Petroleum Inc. - Contr.

Spudding Date _____

Drlg. Data

M I R

J. G. McGEHEE

Sec. 13 (Blk. Twp.) 20 (Sur. Rge.) 14W Map No.

Well No. 1 Farm Moses

Elev.	1881	Location	NW NE SW
-------	------	----------	----------

A 10x10 grid. The word "COMPLETE" is written in the top row, spanning from the second column to the eighth column. A small circle is located in the second row, second column.

1st. Report

Completion JAN 13 1954

Remarks

Petroleum Inc. - Contr.

Spudding Date 11-3-53

Drlg. Data Oil well TD 3550

8" @ 498 Heeb. 3140 Br. lime 3240

Lans. 3253 DST 3295-3340 open 1 hr.

Rec. 240' hocrn 600' froggy oil 850#

DST 3392-3426 open 1 hr. Rec. 430' sw

1090# Arb. 3542 TD 3550 4 $\frac{1}{2}$ " @ 3450

48/3322-34 1250 A S/ 3 boph

Comp. 35 bopd 35% wtr.

J. G. McGEHEE