

KANSAS

Section 17 Township 25 Range 1EWell No. 1 LewisCompany Chas. Gould et al

Misc.

NORTH

WEST

EAST

							0

SOUTH

Sedgwick KANSAS

Sec. 17 Twp. 25 R. 1E ✓

Well No. #1 Lewis Farm

Chas. Gould et al

Miscellaneous (Gould, Cont.) Company


330' Ft. from N. Line

 Ft. from S. Line

330' Ft. from E. Line

 Ft. from W. Line

NE/C

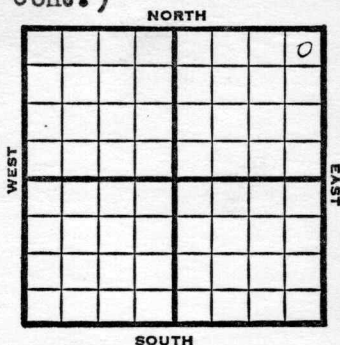

1949

Elev 1433'

REPORT

8/10

8" @ 179'

Drlg. 1250'

8/17

Miss 3008'

TD 3034'

8/24

TD 3435'

Viola 3292'

Simp Sd 3432'

Aband.

ABANDONED

Kansas

Map No. _____ Sec. 17 Twp. 25 R. 1EWell No. 1 Lewis

Chas. Gould et al. _____ Company

Gould _____ Contractor


NE/C

FIRST REPORT
SECTION PLAT330 Ft. from N. Line

_____ Ft. from S. Line

330 Ft. from E. Line

_____ Ft. from W. Line

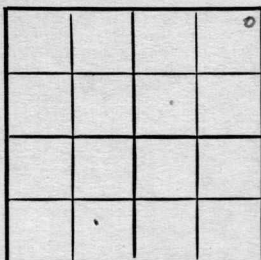

Sedgwick County

RECORD

Location _____

Cased _____ in., _____ ft.

Rig up _____

Sand _____

Drilling and Remarks:

Gas _____

Oil _____

Total Depth _____

8" @ 179

drlg. 1250

PRODUCTION

1st 24 hrs. Nat. _____

1st 24 hrs. after shot _____

Gas _____ Cu. Ft.

Dry Hole _____

Abandoned _____

Date

AUG 10 1949

19

S. J. LEWIS

Scout

Map No. K13 Sec. 17 Twp. 25 R. 1E

Well No. 1 Lewis

Chas. Gould et al. Company

ABANDONED

Contractor

NE/C


E 1/4 33
SECTION PLAT

330 Ft. from N. Line

_____ Ft. from S. Line

330 Ft. from E. Line

_____ Ft. from W. Line

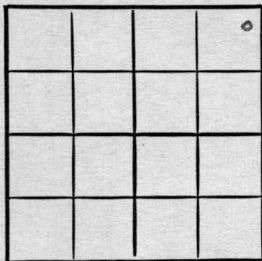

Sedgwick County

Location _____

Rig up _____

Drilling and Remarks:

Viola 3292

Single Sol 3432

RECORD

Cased _____ in., _____ ft.

Sand _____

Gas _____

Oil _____

Total Depth 3435

PRODUCTION

1st 24 hrs. Nat. _____

1st 24 hrs. after shot _____

Gas _____ Cu. Ft.

Dry Hole _____

Abandoned _____

Date

AUG 24 1949 19

S. J. LEWIS Scout