


Section 20 Township 20 Range 14WWell No. #1 SmithCompany Kansas-Nebraska

KANSAS

Barton

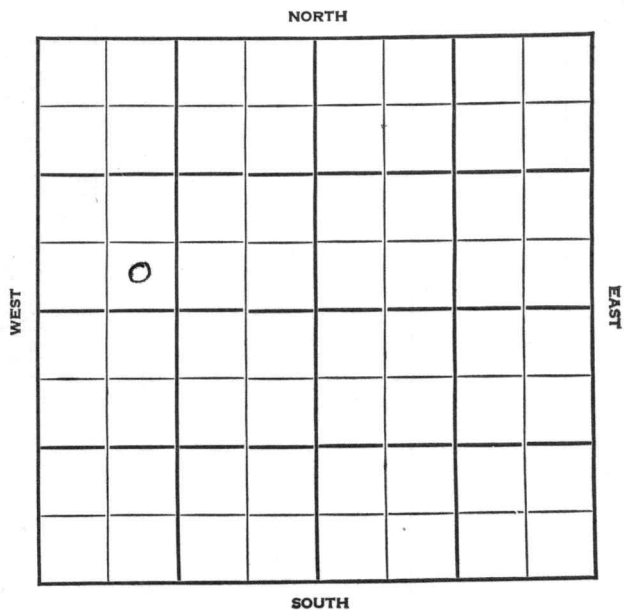

Sec. 20 Twp. 20 R. 14W

Well No. #1 Smith Farm

Kansas-Nebraska

Company

Unruh Pool

Ft. from N. Line

330'


Ft. from S. Line

Ft. from E. Line

990'

Ft. from W. Line

SE SW NW

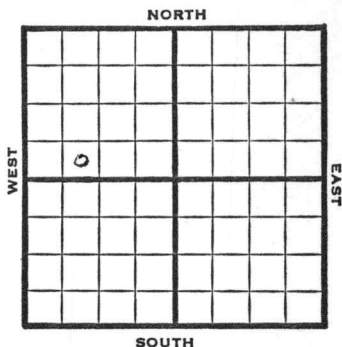

1948

R E P O R T

6/9 Location

6/16 "

6/23 "

6/29 "

7/8 "

7/14 "

7/21 "

7/28 "

8/4 Loc

Aband.

ABANDONED

Barton County Kansas State

Map No. 82 Sec. 20 Twp. 20 R. 14W

Well No. 1 Smith

Kansas - Nebraska Company

ABANDONED Contractor

SE SW NW

SECTION PLAT

	0						

 Ft. from N. Line

330 Ft. from S. Line

 Ft. from E. Line

990 Ft. from W. Line

Unruh Pool

Remarks:

Loc

Date
AUG 4 1948

Scout S. J. LEWIS

Kansas

Map No. _____ Sec. 20 Twp. 20 R. 14WWell No. 1 Smith

Kansas - Nebraska

Company _____

FIRST REPORT

Contractor _____

SE SW NW

SECTION PLAT

_____ Ft. from N. Line

330 Ft. from S. Line

_____ Ft. from E. Line

990 Ft. from W. Line

Barton County

Location X

Rig up _____

Drilling and Remarks:

RECORD

Cased _____ in., _____ ft.

Sand _____

Gas _____

Oil _____

Total Depth _____

PRODUCTION

1st 24 hrs. Nat. _____

1st 24 hrs. after shot _____

Gas _____ Cu. Ft.

Dry Hole _____

Abandoned _____

Date

JUN 9 1948 19S. J. LEWIS Scout