


Section 18 Township 25 Range 1E

Well No. 1 Mann

Company Chas. Gould

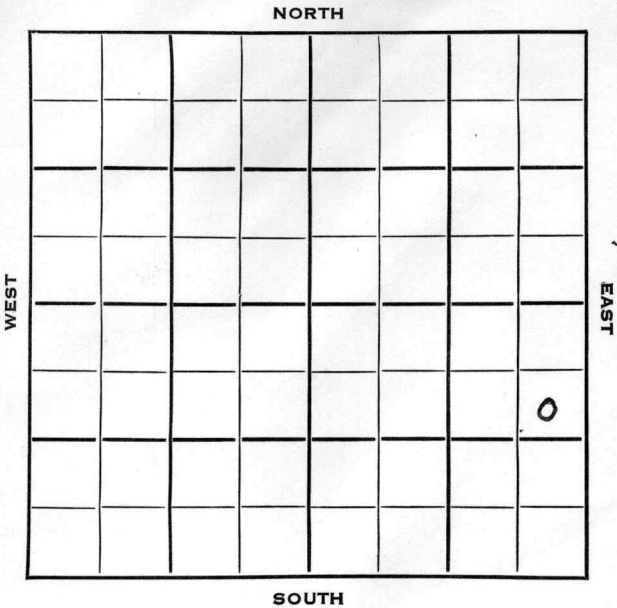

SEC.	TWP.	R.
18	25	1E ✓

WELL NO.

1 Mann

FARM

COMPANY

Chas. Gould

CONTRACTOR

Salina Drlg.
Goodrich Pool

990

Ft. from N. Line


Ft. from S. Line

330

Ft. from E. Line

Ft. from W. Line

SE NE SE

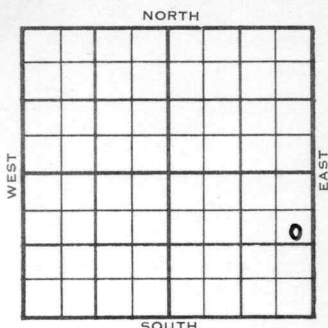

1954

ELEVATION

1382'

REPORT

2/10

RUR

3/3

Spud 2-11-54 D & A TD 3583'

8" @ 185 Lans. 2340 KC 2557

TD 3583 DST 2722-28 open 1 hr

rec 6' mud.

DST 2732-38 open 1 hr rec 360' SW

B KC 2748 Burgess 3020' Miss 3032

Hunton 3396

DST 3398-3406 open 1 hr rec 710'

sul. wtr. 1165# Maq. 3437

DST 3432-34 open 1 hr rec 1200' sul.

wtr. 1285# Viola 3460 Simp 3483

Arb. 3554


DST 3462-67 open 3/4 hr rec 710' sul

wtr. 1175#

D & A

ABANDONED

County Sedgwick State Kansas
 Sec. 18 (Blk.) 25 (Sur.) 1E Map No.
 Operator Chas. Gould
 Well No. 1 Farm Mann
 Elev. 1382 Location SE NE SE

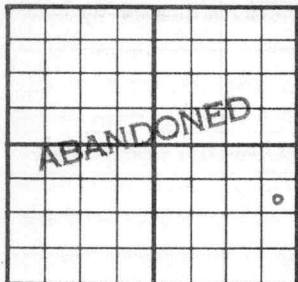

990 Ft. From N Line SE
330 Ft. From E Line Quarter
 1st. Report
 Completion MAR 3 1954
 Remarks Goodrich Pool
Salina Drlg. - Contr.
 Spudding Date 2-11-54

Drlg. Data D & A TD 3583
8" @ 185 Lans. 2340 KC 2557
TD 3583 DST 2722-28 open 1 hr.
Rec. 6' mud DST 2732-38 open 1 hr.
Rec. 360' sw B KC 2748 Burgess 3020
Miss. 3032 Hunton 3396 DST 3398-3406
open 1 hr. Rec. 710' sul. wtr. 1165#
Maq. 3437 DST 3432-34 open 1 hr.
Rec. 1200' sul. wtr. 1285# Viola 3460
Simp. 3483 Arb. 3554 DST 3462-67
open 3/4 hr. Rec. 710' sul. wtr. 1175#
D & A

J. G. McGEHEE