

Section 19 Township 20 Range 14WWell No. #4 Schmidt HeirsCompany Magnolia Pet. Company

NORTH

	0						

SOUTH

Barton

KANSAS

Sec. 19 Twp. 20 R. 14W

Well No. #4 Schmidt Heirs Farm

Magnolia Petr. Co. Company

Mallonee Contractor

Unruh Pool


Ft. from N. Line

330 Ft. from S. Line

Ft. from E. Line

990 Ft. from W. Line

SE SW SW

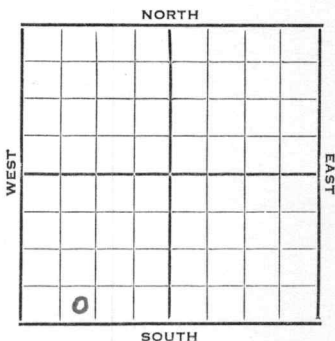

1953 Elev. 1914'


REPORT

7/8 MIRT

7/22 9" @ 918 w/400
Drlg. 3572'

8/19 Spud 7-7-53
Oil Well
TD 3680'
9" @ 918'
Heeb 3216, Lans 3314,
DST 3590-3602 opn 1 hr, rec 5' mud Off
Viola 3553, Arb 3620,
DST 3628-38 opn 35 min, 1½ mcfg spray
oil in 17 min, rec 180' oil, 660' ocs
1085#
TD 3680'
5" @ 3678'
CO to 3648'
24/ 3587-92 ½ gwph & SSO Hydro.
250 mud acid 1000 A S/ sw CO to
3648
12/ 3630-33 B/ 7 goph 250 A
P/ 15 bo 100 bw 15 hr.
Comp. 50 bopd 50 bw.

COMPLETED

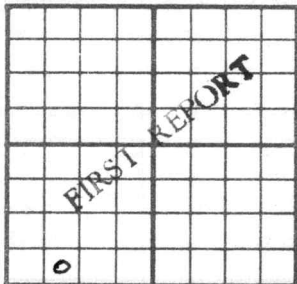County Barton State KansasSec. 19 (Blk. Twp.) 20 (Sur. Rge.) 14W Map No.Operator Magnolia Pet. Co.Well No. 4 Farm Schmidt HeirsElev. Location SE SW SW330 Ft. From S Line SW990 Ft. From W Line Quarter1st. Report JUL 8 1953

Completion

Remarks

Mallonee - Contr.

Spudding Date

Drlg. Data Unruh poolMIRT

J. G. McGEHEE

