

Sedgwick

Map No. *Kans* Sec. *6* Twp. *25* R. *1^E*

Well No. *1 W^m Moore* Farm


Preston Jack + Ades Company

_____ Ft. from N. Line

1070 Ft. from S. Line

_____ Ft. from E. Line

1070 Ft. from W. Line

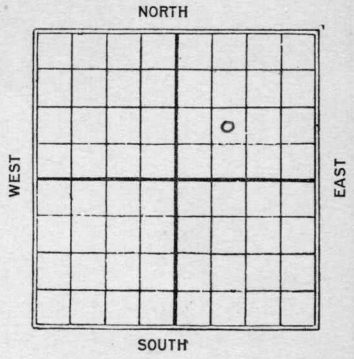

Beneal

Date <i>1925</i>	REPORT
<i>1/14</i>	<i>Spud + S.D</i>
<i>1/21</i>	_____
<i>6/5</i>	<i>Spudded + S.D</i>
<i>7/5</i>	_____
<i>7/22</i>	_____
<i>7/29</i>	_____
<i>8/5</i>	_____
<i>8/19</i>	_____
<i>8/27</i>	_____
<i>9/3</i>	_____
<i>9/9</i>	_____
<i>9/30</i>	_____
<i>10/6</i>	_____
<i>10/13</i>	_____
<i>10/31</i>	_____
<i>10/28</i>	_____
<i>11/4</i>	_____
<i>11/8</i>	_____
<i>1926</i>	
<i>4/14</i>	_____
<i>4/21</i>	_____

4/29 - Spudded and S.D.
 5/5 - _____
 5/11 - Same.
 5/12 - 350' S.D. for new engine
 5/26 - same
 6/2 - same
 6/9 - _____
 6/16 - _____
 6/23 - _____
 6/30 - _____
 7/14 - _____
 7/22 - _____
 8/11 - _____
 8/18 - _____
 8/25 - _____

9/1 - _____
 9/8 - Spud & S.D.

9/15 - _____
 9/22 - _____
 9/29 - _____
 10/6 - _____
 10/13 - _____
 10/20 - _____
 10/27 - _____
 11/3 - _____
 11/10 - _____
 11/17 - same
 11/24 - same
 12/1 - Spudding

12/8 - Spud 120'
 12/15 - Drlg 375'
 12/21 - " 610
 12/29 - " 1500
 1927
 1/5 - Drlg. 2000
 1/12 - T.D. 2430 - SD
 1/19 - Drlg - 2550
 1/26 - T.D. 2550. Collapsed 8"
 2/2 - T.D. 2550 - fishing pipe
 2/9 - Drilling 2750
 2/16 - " 2820
 2/23 - " 2883

3/2 - Drlg 3080
 3/9 - " 3140
 3/16 - " 3305
 3/23 - top line
 3080 - 5" @
 3400.
 Drlg 3430-
 3/30 - Drlg 3495
 in Viola
 4/6 - Drlg 3605
 4/13 - Drlg 3700 - H.F.W.
 4/20 - T.D. 3700
 S.D. for high water
 4/27 - _____
 5/4 - T.D. 3857
 S.Y.A.

Sedgwick

Map No. **13** **KANSAS** Sec. **6** Twp. **25** R. **1 E**

Well No. *1 Wm Moore*

Preston Tack & Ades Company

Contractor

FIRST REPORT

SECTION PLAT

		0	

-----Ft. from N. Line

1070 Ft. from S. Line

-----Ft. from E. Line

1070 Ft. from W. Line

Location -----

Rig up -----

Drilling and Remarks:

spud + S.D.

RECORD

Cased ----- in., ----- ft.

Sand -----

Gas -----

Oil -----

Total Depth -----

PRODUCTION

1st 24 hrs. Nat. -----

1st 24 hrs. after shot -----

Gas ----- Cu. Ft.

Dry Hole -----

Abandoned -----

Date

1/14 1925

M. A. BENEAR

Scout

②

MAP NO. K13 SEC. 6 TWP. 7SS R. 1E

WELL NO. 1 Mitchell

Boyle + Jack COMPANY

CONTRACTOR

SECTION PLAT

_____ FT. FROM N. LINE

_____ FT. FROM S. LINE

_____ FT. FROM E. LINE

_____ FT. FROM W. LINE

RECORD

LOCATION _____

CASED _____ IN., _____ FT.

RIG UP _____

SAND _____

DRILLING AND REMARKS:

GAS _____

Our map shows 3857 dry

OIL _____

TOTAL DEPTH _____

PRODUCTION

1ST 24 HRS. NAT. _____

1ST 24 HRS. AFTER SHOT _____

GAS _____ CU. FT.

DRY HOLE _____

ABANDONED _____

DATE

8/17

no depth this well

③ MAP No. K13 SEC. 6 TWP. 755 R. 1E
 WELL No. 1 Metcalf

 COMPANY _____
 CONTRACTOR _____

SECTION PLAT

		o	

 FT. FROM N. LINE

 FT. FROM S. LINE

 FT. FROM E. LINE

 FT. FROM W. LINE

RECORD

LOCATION _____
 RIG UP _____
 DRILLING AND REMARKS:

CASED _____ IN., _____ FT.
 SAND _____
 GAS _____
 OIL _____
 TOTAL DEPTH 3857

*dry hole
 OK on mig
 3857 Lm*

PRODUCTION

1ST 24 HRS. NAT. _____
 1ST 24 HRS. AFTER SHOT _____
 GAS _____ CU. FT.
 DRY HOLE
 ABANDONED

DATE

5/3 1927

SCOUT

Seelywick

Map No. **KANSAS** Sec. *6* Twp. *25* R. *1E*

Well No. *1 Wm Moore*

Preston Tack et al Company

Contractor

SECTION PLAT

----- Ft. from N. Line

1070 Ft. from S. Line

----- Ft. from E. Line

1070 Ft. from W. Line

		0	

ABANDONED

Location -----

Rig up -----

Drilling and Remarks:

TJ 3857

D & H

RECORD

Cased ----- in., ----- ft.

Sand -----

Gas -----

Oil -----

Total Depth -----

PRODUCTION

1st 24 hrs. Nat. -----

1st 24 hrs. after shot -----

Gas ----- Cu. Ft.

Dry Hole -----

Abandoned -----

Date

MAY 4 1927

S. J. LEWIS

Scout