


Section 9 Township 25S Range 1E

Well No. #1 Methodist Home

Company E. H. Adair

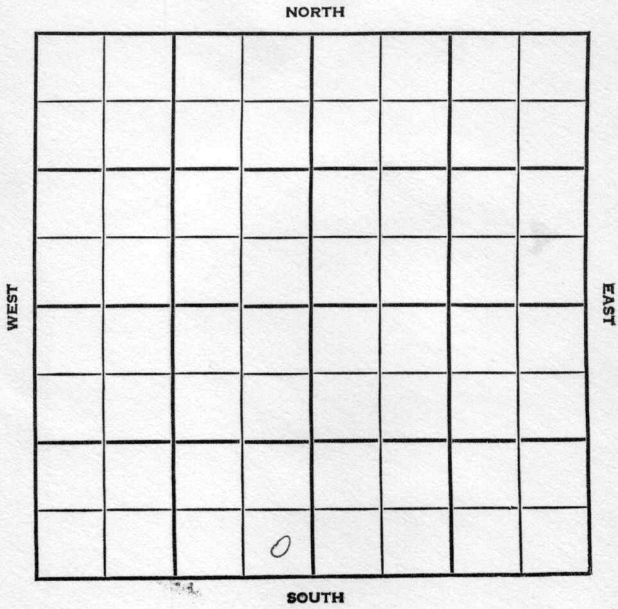

County Sedgwick Elev. 1437
 Sec. 9 Twp. 25S Rge. 1E
 Company E. H. Adair
 Farm Name Methodist Home No. 1

TOPS	DEPTH	LOG	DATUM	Loc. in Sec.
Anh.				SE SE SW
TP.	2279	2276		
H.				
Tr.				
Dg.				
Bl.				
L.	2349	2344		Geol.
K.C.	2548	2558		
B.K.C.		2750		Concr.
Ce.				Co.
C.				
M.		3054		Pool
M.				
K.				Wildcat
Mz.				
Ma.				
V.				
S.				
S.				
A.				
R.				
Pe.				
G.				
T.D.	3058			

ABANDONED

Date Comm. AUG 22 1956
NIRT AUG 15 '56 8-7-56 8278
155/135 DST 2647-63 wpr
1hr 5' Md BHP 890/20" DST
2709-23 30" net 10' Md BHP
900/20" DST 2738-54 1hr net
20' Md BHP 900/20 ID 2754
AUG 22 '56 DST 3049-~~28~~ 1hr 63'
WM 820/20
D.E.A.