

KANSAS


Greenwood

FORM 51 5M PETROL

Section 7 Township 25 Range 9E

Well No. 1 Wilkenson "C"

Company Franco Central

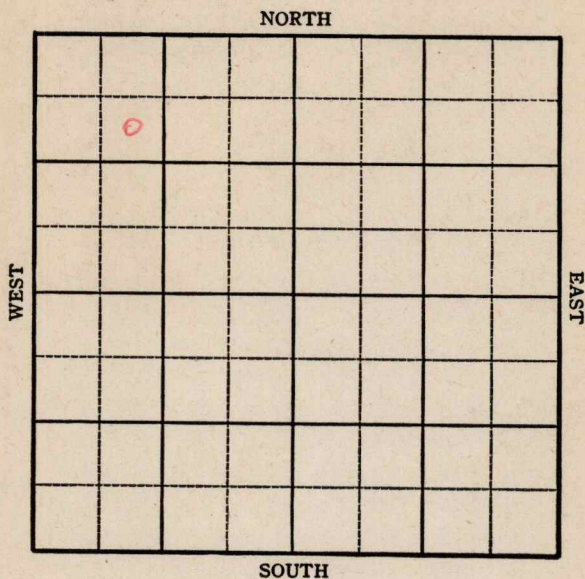

KANSAS Greenwood

Sec. 7 Twp. 25 R. 9-E

Well No. #1 Wilkenson "C" Farm


Franco Central Company

990 Ft. from N. Line

 Ft. from S. Line

 Ft. from E. Line

990 Ft. from W. Line

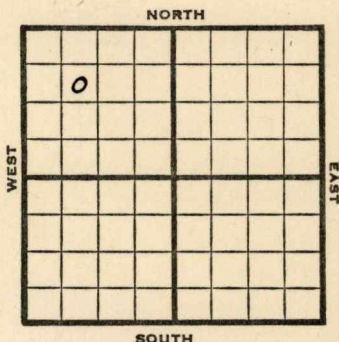

SE NW NW

1945

REPORT

10/24 8" @ 1470'
Sd. 2211-33
SO
TD 2240'
16" @ 2210'
50 qts.

10/31 Sd. 2211
6" @ 2210
50 qts.
TD 2240
Pump 35 Pot.
Grav. 38.0

COMPLETED

KANSAS
KansasPool Name MiscellaneousMap No. 15 Sec. 7 Twp. 25 R. 9EWell No. 1 Wilkenson "C"

Franco Central

Company

FIRST REPORT

Contractor

SE NW NW

SECTION PLAT

6			

990 Ft. from N. Line Ft. from S. Line Ft. from E. Line990 Ft. from W. LineGreenwood CountyLocation Rig up

Drilling and Remarks:

8"-1470

Sd. 2211-33

SO

TD. 2240

16"-2210

50 qts.

RECORD

Cased in., ft.Sand Gas Oil Total Depth

PRODUCTION

1st 24 hrs. Nat. 1st 24 hrs. after shot Gas Cu. Ft.Dry Hole Abandoned

Date

OCT 24 1945 19S. J. LEWIS Scout

Pool Name Miscellaneous

Kansas

KANSAS

Map No. 15 Sec. 7 Twp. 25 R. 9EWell No. 1 Wilkenson "C"

France Central

Company

COMPLETED

Contractor

SE NW NW

SECTION PLAT

990

Ft. from N. Line

Ft. from S. Line

Ft. from E. Line

990

Ft. from W. Line

2			

Greenwood County

Location

Rig up

Drilling and Remarks:

*Sol 221**6" C 2210**509 to**Pump 35 ft**35 ft*

RECORD

Cased _____ in., _____ ft.

Sand _____

Gas _____

Oil _____

Total Depth 2240

PRODUCTION

1st 24 hrs. Nat. _____

1st 24 hrs. after shot _____

Gas _____ Cu. Ft.

Dry Hole _____

Abandoned _____

Date

OCT 31 1945

19

S. J. LEWIS

Scout