


Map No. 15 Sec. 8 Twp. 25 R. 9
Well No. Gregg & Caunter Farm
Connell et al Company

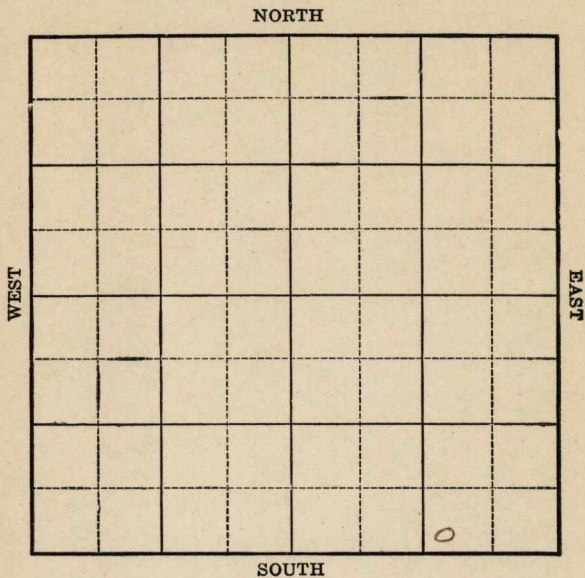

Location _____

Drilling Remarks:

RECORD

Cased _____ in. _____ ft.

Sand _____

Gas _____

Oil _____

Total Depth _____

Rig Up _____

Drilling Remarks:

PRODUCTION


1st 24 hrs. Nat. _____

1st 24 hrs. after shot _____

Gas _____ cu. ft.

Dry Hole _____

Abandoned _____

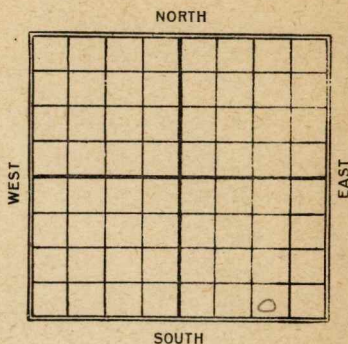Map No. K Sec. 8 Twp. 25 R. 9Well No. 1 Gregg + Canter Farm
Cannell et al Company Ft. from N. Line200 Ft. from S. Line1120 Ft. from E. Line Ft. from W. Line

Date

REPORT

192410/8 Location11/26 dy @ 1225'12/17 sand 2331-51 dyLQ + A 2405'12/30 S. + A. 2405'

KAN3AS

Map No. _____ Sec. 8 Twp. 25 R. 9

Well No. 1 Gregg & Carter

Cannell et al Company

Contractor

FIRST REPORT

SECTION PLAT

_____ Ft. from N. Line

200 Ft. from S. Line

1120 Ft. from E. Line

_____ Ft. from W. Line

			e

Location ✓✓

Rig up _____

Drilling and Remarks:

RECORD

Cased _____ in., _____ ft.

Sand _____

Gas _____

Oil _____

Total Depth _____

PRODUCTION

1st 24 hrs. Nat. _____

1st 24 hrs. after shot _____

Gas _____ Cu. Ft.

Dry Hole _____

Abandoned _____

Date

M. A. BENEAR

OCT 8 1924

Scout

Map No. 15 Sec. 8 Twp. 25 R. 9 ^E

Well No. 1 Gregg & Cauter

Cannell & Co Company

Contractor

SECTION PLAT

ABANDONED

_____ Ft. from N. Line

200' Ft. from S. Line

120' Ft. from E. Line

_____ Ft. from W. Line

			o

Location _____

Rig up _____

Drilling and Remarks:

Dry sand. 2331-51

10492405

RECORD

Cased _____ in., _____ ft.

Sand _____

Gas _____

Oil _____

Total Depth _____

PRODUCTION

1st 24 hrs. Nat. _____

1st 24 hrs. after shot _____

Gas _____ Cu. Ft.

Dry Hole _____

Abandoned _____

Date

12-30 192 4

M.A.B. Scout