


Section 12 Township 25 Range 1 E

Well No. # 2 Wehmier (*Weimeier*)

Company J. P. Gaty

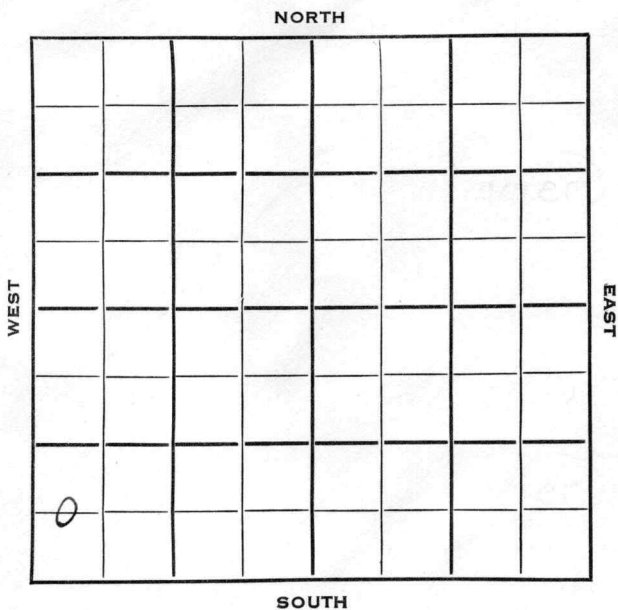

Sedgwick

KANSAS

SEC.

TWP.

R.

12

25

1 E

WELL NO.

2 Wehmier

FARM

COMPANY

J. P. Gaty

CONTRACTOR

Salina Drlg.

N. Kuske Pool

Ft. from N. Line

660


Ft. from S. Line

Ft. from E. Line

330

Ft. from W. Line

C W L SW SW

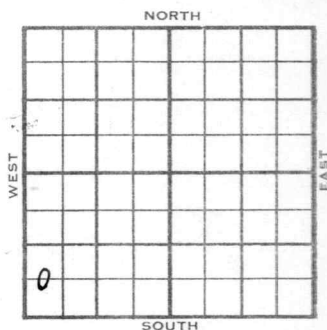

1954

ELEVATION

1458'

REPORT

4/14

Spud 4-7-54

Drlg. 831'

5/12

Spud 4-7-54

D&A

TD 3078'

8" @ 125'

KC 2551', Burgess 3049'

TD 3078'

5" @ 3078'

CO to 3071'

24/3050-55 wtr.

D&A

ABANDONED

County Sedgwick State KansasSec. 12 (Blk.) 25 (Sur.) 1E Map No.Operator J. P. GatyWell No. 2 Farm WehmierElev. Location C WL SW SW

660 Ft. From S Line SW330 Ft. From W Line Quarter1st. Report APR 14 1954


Completion

Remarks

Salina Drlg. - Contr.Spudding Date 4-7-54Drlg. Data N. Kuske Pooldrlg. 831

J. G. McGEHEE

County Sedgwick State Kansas
 Sec. 12 (Blk. 25 (Sur. 1E Map No.
 (Twp. (Rge.)
 Operator J. P. Gaty
 Well No. 2 Farm Wehmier
 Elev. 1458 Location C W L SW SW

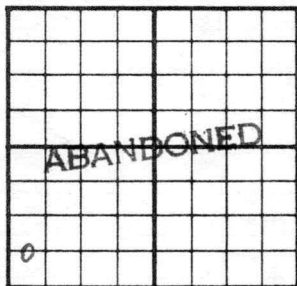

660 Ft. From S Line SW
330 Ft. From W Line Quarter

1st. Report

Completion MAY 12 1954

Remarks N. Kuske Pool
Salina Drlg. - Contr.

Spudding Date 4-7-54

Drlg. Data D & A TD 3078

8" @ 125 KC 2551 Burgess 3049

TD 3078 5" @ 3078 CO to 3071

24/ 3050-55 wtr.

D & A

J. G. McGEHEE