


Section 17 Township 20 Range 13W

Well No. #1 Titus

Company Petroleum Inc.

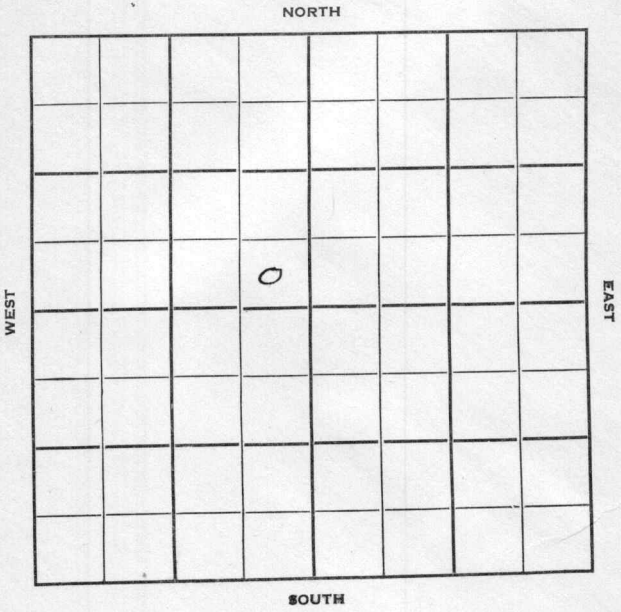

Sec. 17 Twp. 20 R. 13W

Well No. #1 Titus Farm

Petroleum, Inc. Company

Contractor

Wildcat Arb Test


Ft. from N. Line

330' Ft. from S. Line

330' Ft. from E. Line

Ft. from W. Line

SE SE NW

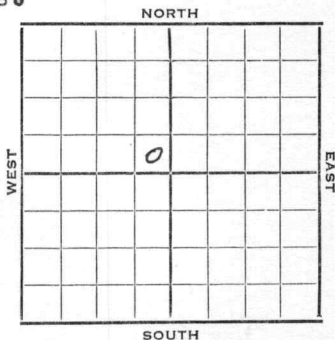

1952

Elev. 1871'

REPORT

5/7 RUR
 5/14 8" @ 224'
 Drlg. 3053'

5/21 Spud 5-6-52
 D & A TD 3540' 8" @ 224'
 Heeb 3107' Br Lime 3220' Lans. 3233'
 DST 3221-64 open 1 hr. rec 360' gas
 50' SOCM.
 DST 3314-59 open 40 min, rec 30' mud
 DST 3356-3406 open 1 hr. rec 55' OCM
 90' gas.
 Cong. 3471' Arb. 3489'
 DST 3494-3507 open 1 hr. rec 45' OCM
 DST 3497-3519 open 1 hr, rec 50' mud
 DST 3516-40 open 1 hr. rec 610' SW
 TD 3540' D & A

ABANDONED

