


Greenwood

Form 51-5M-4-27-27423

Map No. **KANSAS** Sec. 8 Twp. 25 R. 9
Well No. 1-Hendrickson Farm
Brosius et al Company

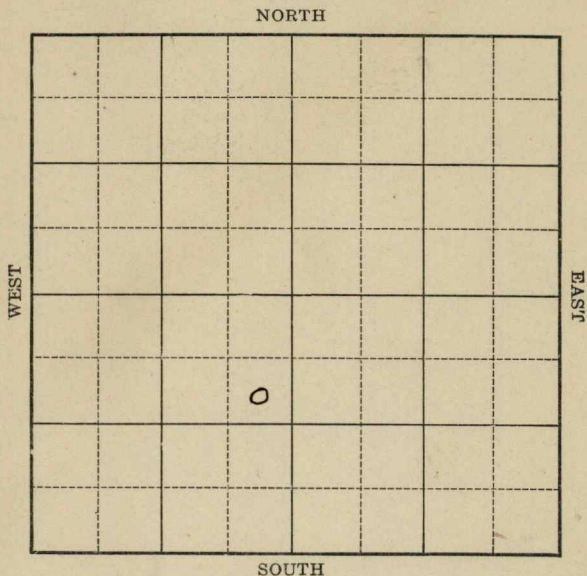

Location _____
Drilling Remarks _____

Rig Up _____
Drilling Remarks _____

RECORD

Cased _____ in. _____ ft.
Sand _____
Gas _____
Oil _____
Total Depth _____

PRODUCTION

1st 24 hrs. Nat. _____
1st 24 hrs. after shot _____
Gas _____ cu. ft.
Dry Hole _____
Abandoned _____

Map No. **KANSAS** Sec. 8 Twp. 25 R. 9

Well No. 1 - Hendrickson Farm


Brosius & Co Company

990 Ft. from N. Line

-----Ft. from S. Line

330 Ft. from E. Line

Ft. from W. Line

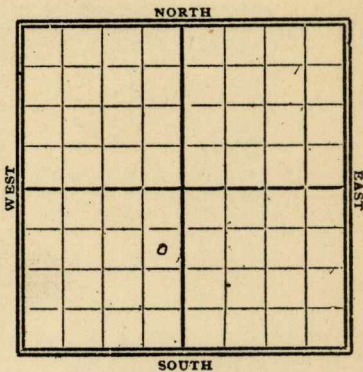

1928

Date _____

REPORT

DATE	REPORT
10/3	Location
10/10	Wrlg 400'
10/17	" 1000'
10/24	" 1360'
10/31	" 2025'
11/7	sdly shale 2267-85 TD 2337'
	Dry & Abandoned

K15 KANSAS

MAP NO. _____ SEC. 8 TWP. 25 R. 9WELL No. 1 HendricksonBrosius et al COMPANY

CONTRACTOR

SECTION PLAT

FIRST REPORTS

990 FT. FROM N. LINE

_____ FT. FROM S. LINE

330 FT. FROM E. LINE

_____ FT. FROM W. LINE

LOCATION ✓

RIG UP _____

DRILLING AND REMARKS:

RECORD

CASED _____ IN. _____ FT.

SAND _____

GAS _____

OIL _____

TOTAL DEPTH _____

PRODUCTION

1ST 24 HRS. NAT. _____

1ST 24 HRS. AFTER SHOT _____

GAS _____ Cu. Ft.

DRY HOLE _____

ABANDONED _____

DATE

OCT 3

1928

CHAS. L. SHERWOOD

192

SCOUT

K15 KANSAS

MAP No. _____ SEC. 8 TWP. 25 R. 9WELL No. 1 HenricksonBrosius et al COMPANY

CONTRACTOR

COMPLETED

SECTION PLAT

990 FT. FROM N. LINE

_____ FT. FROM S. LINE

330 FT. FROM E. LINE

_____ FT. FROM W. LINE

ABANDONED

LOCATION _____

RIG UP _____

DRILLING AND REMARKS:

Sly Shale
2267-85'

RECORD

CASED _____ IN. _____ FT.

SAND _____

GAS _____

OIL _____

TOTAL DEPTH 2337'

PRODUCTION

1ST 24 HRS. NAT. _____

1ST 24 HRS. AFTER SHOT _____

GAS _____ CU. FT.

DRY HOLE ☒ABANDONED ☒

DATE

NOV 7 1928

CHAS. L. SHERWOOD

192

SCOUT