

Section 12 Township 25 Range 1E

Well No. 1 Woulfe

Company A. D. Allison
Birmingham & Bartlett

Wildcat

NE NE NE

NORTH

WEST

EAST

SOUTH

KANSAS

Sedgwick

Sec. 12 Twp. 25 R. 1E ✓

Well No. #1 Woulfe Farm

A.D. Allison
Birmingham & Bartlett Company


Wildcat

330' Ft. from N. Line

Ft. from S. Line

330' Ft. from E. Line

Ft. from W. Line

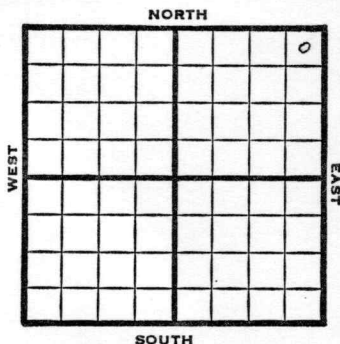

~~NE/G~~ NE NE NE NE

1949

Elev. 1460' **REPORT**

1/12 8" @ 102'

1/19 Burgess 2976'
Drlg. 2990'


1/26 Miss 3026'
TD 3056'

ABANDONED

~~Kaners~~Map No. _____ Sec. 12 Twp. 25 R. 1EWell No. 1 WoulfeBirmingham & Bartlett CompanyFIRST REPORT Contractor

NE/C

SECTION PLAT

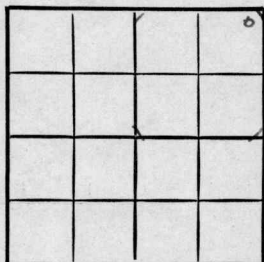330 Ft. from N. Line

_____ Ft. from S. Line

330 Ft. from E. Line

_____ Ft. from W. Line

Sedgwick County

Location _____

Rig up _____

Drilling and Remarks:

8" @ 102

RECORD

Cased _____ in., _____ ft.

Sand _____

Gas _____

Oil _____

Total Depth _____

PRODUCTION

1st 24 hrs. Nat. _____

1st 24 hrs. after shot _____

Gas _____ Cu. Ft.

Dry Hole _____

Abandoned _____

Date

JAN 12 1949

19

S. J. LEWIS

Scout

Map No. 13 Sec. 12 Twp. 25 R. 1E


Well No. 1 Woulfe

Birmingham & Bartlett Company

ABANDONED Contractor

NE/C

211460
SECTION PLAT

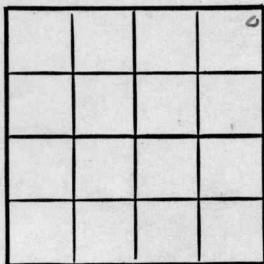

330 Ft. from N. Line

 Ft. from S. Line

330 Ft. from E. Line

 Ft. from W. Line

Sedgwick County

Location

Rig up

Drilling and Remarks:

Miss 3026

RECORD

Cased in., ft.

Sand

Gas

Oil

Total Depth 3058

PRODUCTION

1st 24 hrs. Nat.

1st 24 hrs. after shot

Gas Cu. Ft.

Dry Hole

Abandoned

Date

JAN 26 1949 19

S. J. LEWIS

Scout

O.W.W.O.

FORM 513 SUNRAY

County Sedgwick Elev. 1459 DF
 Sec. 12 Twp. 25 Rge. 1E
 Company A. D. Allison
 Farm Name Woulfe No. 1

TOPS	DEPTH	LOG	DATUM
Anh.			
T.P.			
H.			
Tr.			
Dg.			
BL.			
L.	2296		
K.C.	2322		
B.K.C.			
Ce. <u>Burgess</u>	2976		
C.			
M.	3026		
M.			
K.			
Mz.			
Me.			
V.			
S.			
S.			
A.			
R.			
Pe.			
G.			
T.D. <u>OTD</u>	3056		

Loc. in Sec.

NE NE NE

(OWWO)

Geol.

Contr.

G.D. Smitherman

Pool

FIRST REPORT

AUG 14 1957

Date Comm.

M I R T

29

County Sedgwick Elev. 1459 DF
 Sec. 12 Twp. 25 Rge. 1E
 Company A. D. Allison
 Farm Name Woulfe No. 1

TOPS	DEPTH	LOG	DATUM	Loc. in Sec.
Anh.				NE NE NE
Tr.				(OWWO)
H.				
Tr.				
Dg.				
BL.				
L.	2296			Geol.
K.C.	2522			Contr.
B.K.C.				G.D. Smitherman
Ce. <u>Burgess</u>	2976			Pool
C.				
M.	3026			
M.				
K.	3326			
Mz. <u>H</u>	3399			
Mq.	3446			
V.	3456			
S. <u>Del</u>	3471			
S. <u>Del</u>	3476			
A.	3556			
R.				
PE.				
G.				
T.D. <u>OTD</u>	3575			
	3056			

AUG 21 '57

ABANDONED

Date Comm.

M I R T AUG 21 '57 DST 3399-3406 op 1 hr R.
 2530' SW FP 1045 BHP 1225/20"

D. A. N. L. A. J.