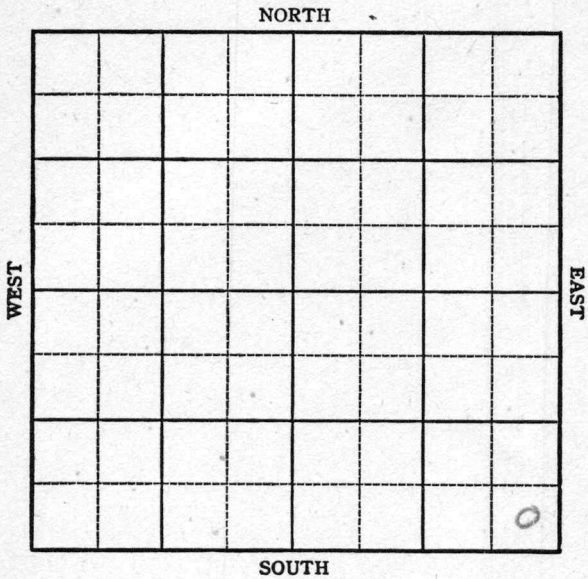


Section 5 Township 21 Range 6-WWell No. #1 EnglelandCompany Cities Service


KANSAS

Rice

Sec. 5 Twp. 21 R. 6-W

Well No. #1 Engleland Farm
C
Cities Service Company
No Name

 Ft. from N. Line
330 Ft. from S. Line
330 Ft. from E. Line
 Ft. from W. Line

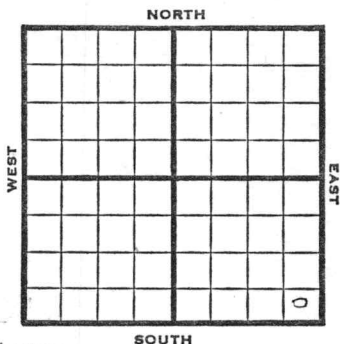

SE/C

Elev. 1658'5

REPORT

1947

3/12 Location

3/18 R U R

3/25 8" @ 211'
Drlg 2170'

4/2 Drlg. 3334'

4/9 Mississippi 3449'
TD 3474'
5" @ 3450' HFO
Swb 151 bbls. oil in 22 hrs.

4/15 TD 3484'
Pump 108 bbls. oil in 12 hrs.

4/23 " " "

4/29 " " "

5/7 " " "

5/13 " " "

5/20 " " "

OVER

5/28

Miss 3449

5" @ 3450

Pump 180 Pot

Grav. 39

TD 3484'

COMPLETED

KANSAS

Map No. 48 Sec. 5 Twp. 21 R. 6WWell No. 1 Engleland


Cities Service Company

FIRST REPORT

Contractor

SE/C

SECTION PLAT

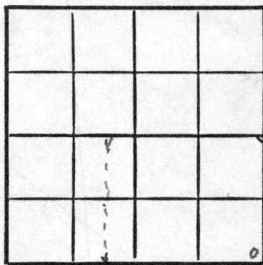

Ft. from N. Line

330 Ft. from S. Line

330 Ft. from E. Line

Ft. from W. Line

Rice County

Location X

Rig up

Drilling and Remarks:

RECORD

Cased _____ in., _____ ft.

Sand _____

Gas _____

Oil _____

Total Depth _____

PRODUCTION

1st 24 hrs. Nat. _____

1st 24 hrs. after shot _____

Gas _____ Cu. Ft.

Dry Hole _____

Abandoned _____

Date

MAR 12 1947

19

S. J. LEWIS

Scout

KANSAS

Brandenstine

Kansas

Map No. 1C48 Sec. 5 Twp. 21 R. 6WWell No. 1 EnglelandCities Service CompanyCOMPLETE Contractor

SE/C

E11608

SECTION PLAT

 Ft. from N. Line330 Ft. from S. Line330 Ft. from E. Line Ft. from W. LineRice CountyLocation Rig up

Drilling and Remarks:

*Miss 3449**5" CO 450**Pump 180 BT**3924*

RECORD

Cased in., ft.Sand Gas Oil Total Depth 3454

PRODUCTION

1st 24 hrs. Nat. 1st 24 hrs. after shot Gas Cu. Ft.Dry Hole Abandoned

Date

MAY 28 1947

19

S. J. LEWIS

Scout