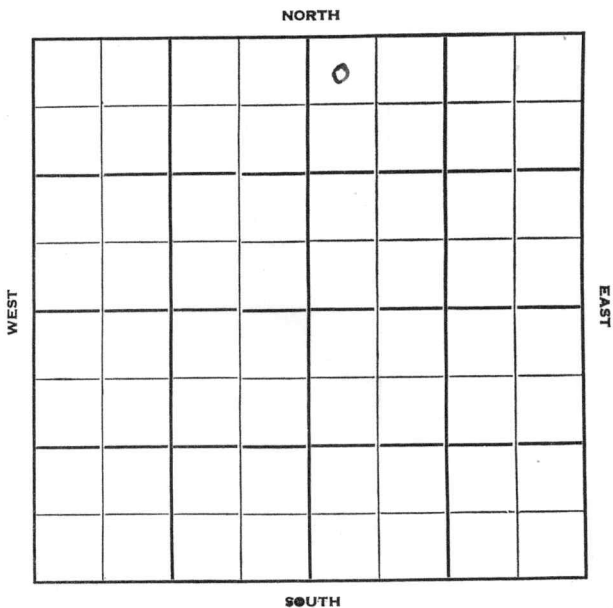


Section 4 Township 21 Range 6 WWell No. # 7 JohnsonCompany Davis-Childs

Rice KANSAS

Sec. 4 Twp. 21 R. 6 W ✓

Well No. # 7 Johnson Farm

Davis-Childs Company

Sterling Contractor
Welsh


330 Ft. from N. Line

 Ft. from S. Line

 Ft. from E. Line

330 Ft. from W. Line

NW NW NE

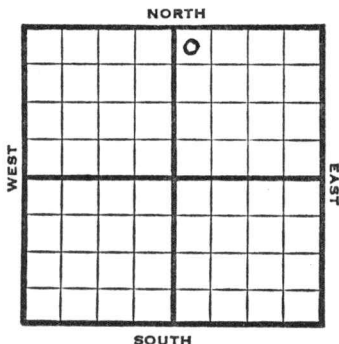

1952

Elev. 1620' REPORT

1/16

Spud 1-14-52
8" @ 138
Drlg. 975'

2/6

TD 3431 8" @ 3421 Hydra Testing
POP

2/13

2/20

Spud 1-14-52
Oil well TD 3433' 8" @ 138
Cong. 3389' Miss 3411-3431'
5" @ 3431 TD 3433' S/6 BOPH
Hydro.
Comp. 100 BOPD
COMPLETED

County **Rice** State **Kansas**
 Sec. **4** (Blk.) **21** (Sur.) **6W** Map No.
 (Twp.)
 Operator **Davis - Childs**
 Well No. **7** Farm **Johnson**
 Elev. Location **NW NW NE**

FIRST REPORT


330 Ft. From **N** Line **NE**
330 Ft. From **W** Line Quarter
 1st. Report **JAN 1 6 1952**
 Completion
 Remarks
Sterling - Contr.
 Spudding Date **1-14-52**

Drlg. Data **Welsh**

8" @ 138 Drlg. 975

J. E. TYRA

County Rice State Kansas
 Sec. 4 (Blk. 21 (Sur. 6 W Map No.
 (Twp. (Rge.
 Operator Davis - Childs
 Well No. 7 Farm Johnson
 Elev. 1620 Location NW NW NE

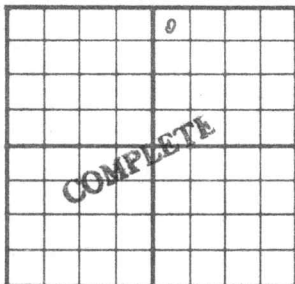

330 Ft. From N Line NE
330 Ft. From W Line Quarter
 1st. Report
 Completion FEB 20 1952
 Remarks Welsh Pool
Sterling Drlg. - Contr.
 Spudding Date 1-14-52

Drlg. Data Oil well TD 3433
8" @ 138 Cong. 3389 Miss. 3411-3431
5" @ 3431 TD 3433 S/ 6 boph Hydro.
Comp. 100 bopd

J. G. McGEHEE