

Section 13 Township 25 Range 1E

Well No. #2 Kuske

Company J.P. Gaty

NORTH

	0						

WEST

EAST

SOUTH

Sec. 13 Twp. 25 R. 1E

Well No. #2 Kuske Farm

J. P. Gaty Company

Contractor

**Kuske Pool**


330 Ft. from N. Line

\_\_\_\_\_ Ft. from S. Line

\_\_\_\_\_ Ft. from E. Line

990 Ft. from W. Line

NE NW NW

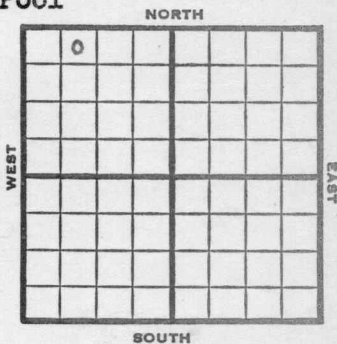

**1953** Elev. 1457' **REPORT**

**7/29** **Location**

**8/19** Spud 7-30-53  
 Oil Well  
 TD 3034  
 8" @ 107  
 Burgess 3029  
 TD 3032  
 5" @ 3031  
 DD 3034  
 FU 2250' oil 12hrs.  
 Comp. 50 bopd

**COMPLETED**



County Sedgwick State Kansas

Sec. 13 (Blk. Twp.) 25 (Sur. Rge.) 1E Map No.

Operator J. P. Gaty

Well No. 2 Farm Kuske

Elev. 1457 Location NE NW NW

0					

330 Ft. From N Line NW

990 Ft. From W Line Quarter

1st. Report

Completion AUG 10 1953

Remarks Kuske Pool

Spudding Date 7-30-53

Drlg. Data Oil well TD 3034

8" @ 107 Burgess 3029 TD 3032

5" @ 3031 DD 3034 FU 2250' oil 12 hr.

Comp. 50 bopd