

Section 20 Township 20 Range 14W

Well No. 1 Unruh

Company Kansas - Nebraska
Unruh

NORTH

	0						

SOUTH

WEST

EAST

Barton

KANSAS

Sec. 20 Twp. 20 R. 14W

Well No. #1 Unruh Farm

Kansas - Nebraska

Company

Unruh (Brack, Cont.)
Pool


Ft. from N. Line

330' Ft. from S. Line

Ft. from E. Line

990' Ft. from W. Line

NORTH

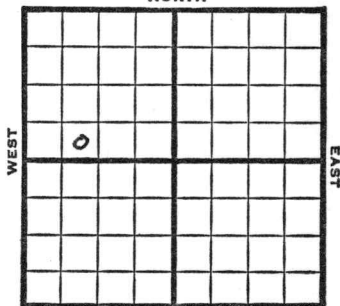

SOUTH

SE SW NW

1949

Elev 1902'

REPORT

7/20

Anhy 860'

8" @ 872

Drlg. 2475'

7/27

Lansing 3304'

Drlg 3521'

8/3

Arb. 3597'

TD 3633-

5" @ 3633'

8/10

TD 3633'

Arb. 3597'

5" @ 3633'

Perf Arb.

1000 acid

3,600,000 Gas

Comp

COMPLETED

Map No. _____ Sec. 20 Twp. 20 R. 14W

Well No. 1 Unruh

Kansas - Nebraska Company

Brack Contractor

FIRST REPORT
SECTION PLAT

SE SW NW

_____ Ft. from N. Line


330

_____ Ft. from S. Line

_____ Ft. from E. Line

990

_____ Ft. from W. Line

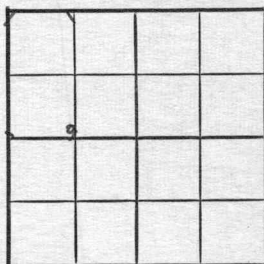

Barton County

Location _____

Rig up _____

Drilling and Remarks:

Anhy 860

8" @ 872

drlg. 2475

RECORD

Cased _____ in., _____ ft.

Sand _____

Gas _____

Oil _____

Total Depth _____

PRODUCTION

1st 24 hrs. Nat. _____

1st 24 hrs. after shot _____

Gas _____ Cu. Ft.

Dry Hole _____

Abandoned _____

Date

JUL 20 1940 19

S. J. LEWIS Scout

Map No. K82 Sec. 20 Twp. 20 R. 14W

Well No. 1 Unruh

Kansas - Nebraska


Company

COMPLETE

Contractor

SE SW NW

E1/902
SECTION PLAT

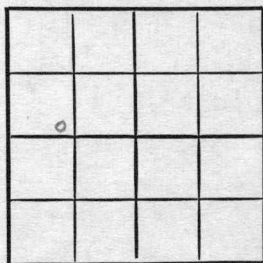

 Ft. from N. Line

330 Ft. from S. Line

 Ft. from E. Line

990 Ft. from W. Line

Barton County

RECORD

Location

Cased in., ft.

Rig up

Sand

Drilling and Remarks:

Gas

Oil

Total Depth 3633

PRODUCTION

1st 24 hrs. Nat.

1st 24 hrs. after shot

Gas Cu. Ft.

Dry Hole

Abandoned

Date

AUG 10 1949 19

S. J. LEWIS

Scout