

KANSAS


FORM 51 5M 6-46 PETROL

Barton county

Section 25 Township 20 Range 14-W

Well No. #1, Davis "C"

Company Bridgeport Oil Company

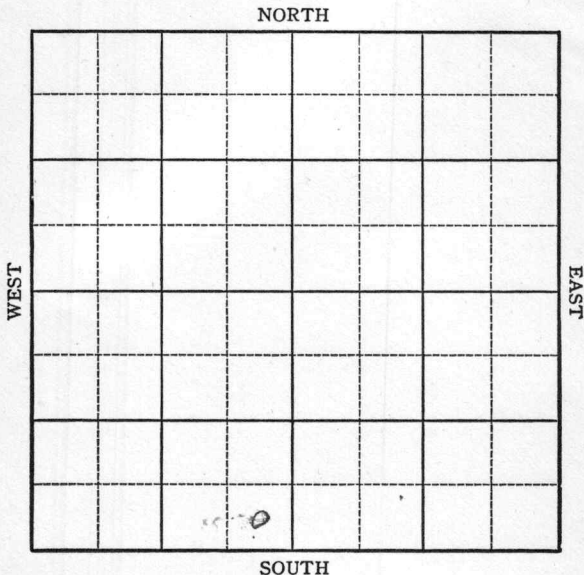

KANSAS

Barton county ✓

Sec. 25 Twp. 20 R. 14-W

Well No. #1, Davis "C" Farm

Bridgeport Company

Hiss

Ft. from N. Line

330'


Ft. from S. Line

330'

Ft. from E. Line

Ft. from W. Line

SE SW

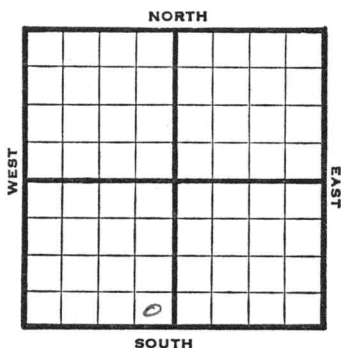

1946

Elev. 1901'

REPORT

10/2

Location

10/8

"

10/15

8" @ 614

Drlg 3250'

10/22

Lans 3262'

Cong 3506'

Arb 3524-30 TD

5" @ 3525, RUST

10/30

Arb 3524'

5" @ 3535'

TD 3543'


ABANDONED

KANSAS

Kansas Pool Name HissMap No. 82 Sec. 25 Twp. 20 R. 14WWell No. 1 Davis "C"Bridgeport CompanyFIRST REPORT Contractor

SE SW

SECTION PLAT

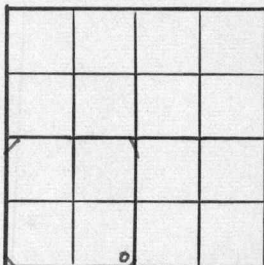 Ft. from N. Line330 Ft. from S. Line330 Ft. from E. Line Ft. from W. LineBarton CountyLocation XRig up

Drilling and Remarks:

RECORD

Cased in., ft.Sand Gas Oil Total Depth

PRODUCTION

1st 24 hrs. Nat. 1st 24 hrs. after shot Gas Cu. Ft.Dry Hole Abandoned

Date

OCT 2 1946 19 S. J. LEWIS Scout

Kansas

Map No. 82 Sec. 25 Twp. 20 R. 14WWell No. 1 Davis "C"


Bridgeport

Company

ABANDONED

Contractor

SE SW

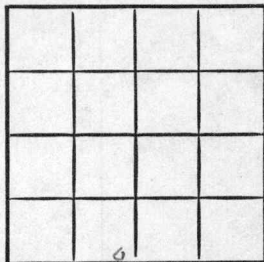E1. 1901
SECTION PLAT Ft. from N. Line330 Ft. from S. Line330 Ft. from E. Line Ft. from W. Line

Barton County

Location Rig up

Drilling and Remarks:

Cr X 3524
5-103525

RECORD

Cased in., ft.Sand Gas Oil Total Depth 2573

PRODUCTION

1st 24 hrs. Nat. 1st 24 hrs. after shot Gas Cu. Ft.Dry Hole Abandoned

Date

OCT 30 1946 19

S. J. LEWIS

Scout