


Section 27 Township 20 Range 14W

Well No. #1 Jettie

Company Phillips

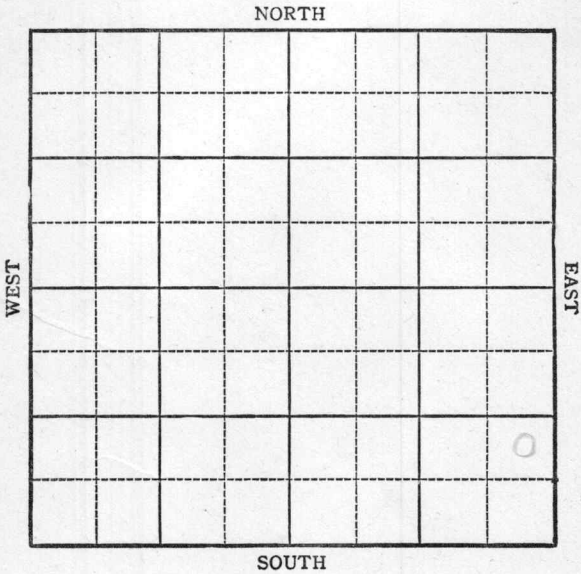

KANSAS


Barton County

Sec. 27 Twp. 20S R. 14W

Well No. #1, Jettie Farm

Phillips Company

Pritchard

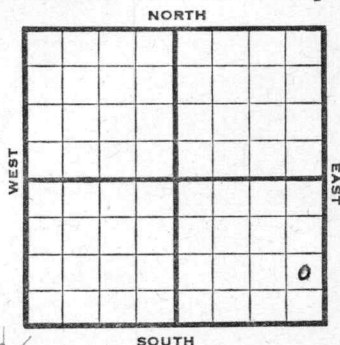

 Ft. from N. Line

990 Ft. from S. Line

330 Ft. from E. Line

 Ft. from W. Line

NE SE SE *Elev. 1906*

1945

R E P O R T

1-10 Rotary
1/17 10" @ 629
Drlg 1800
1/26 Drlg. 3150'
1/31 Lans 3306
Siap 3547
Arb. 3558
Sat. TD 3560'
5" @ 3558' RUST
2/7 " " " "
2/14 " " " "
2/21 500 acid - swb 50 fluid in 1 hr
mostly water
2/28 Coring 3563
3/7 Arb 3558
5" @ 3558
TD 3570' Water

ABANDONED


Pool Name PritchardMap No. 82 Sec. 27 Twp. 20 R. 14WWell No. 1 JettiePhillips Company

FIRST REPORT

Contractor

NE SE SE

SECTION PLAT

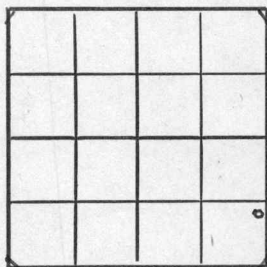 Ft. from N. Line990 Ft. from S. Line330 Ft. from E. Line Ft. from W. LineBartonLocation Rig up

Drilling and Remarks:

rotary

RECORD

Cased in., ft.Sand Gas Oil Total Depth

PRODUCTION

1st 24 hrs. Nat. 1st 24 hrs. after shot Gas Cu. Ft.Dry Hole Abandoned


Date

JAN 10 1945 19S. J. LEWIS Scout

Pool Name PritchardMap No. 82 Sec. 27 Twp. 20 R. 14WWell No. 1 JettiePhillips CompanyABANDONED Contractor

NE SE SE

SECTION PLAT

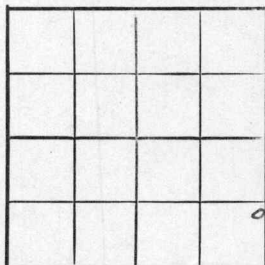 Ft. from N. Line990 Ft. from S. Line330 Ft. from E. Line Ft. from W. LineBarton CountyLocation Rig up

Drilling and Remarks:

Q 83585" @ 8358Watered.

RECORD

Cased in., ft.Sand Gas Oil Total Depth 3570

PRODUCTION

1st 24 hrs. Nat. 1st 24 hrs. after shot Gas Cu. Ft.Dry Hole Abandoned

Date

MAR 7 1945 19S. J. LEWIS Scout