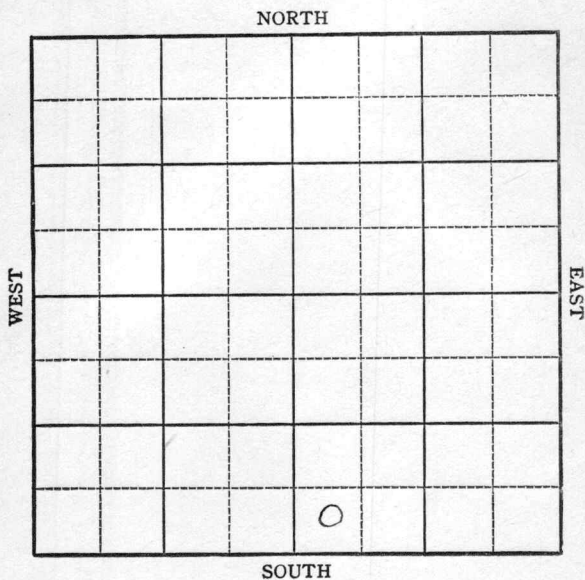


Section 26 Township 20 Range 14WWell No. 1 WilyCompany W.H. Black

KANSAS

Barton

Sec. 26 Twp. 20 R. 14W

Well No. #1 Wyly Farm

W. H. Black

Company

Prichard Pool


 Ft. from N. Line

330' Ft. from S. Line

 Ft. from E. Line

330' Ft. from W. Line

SW SE

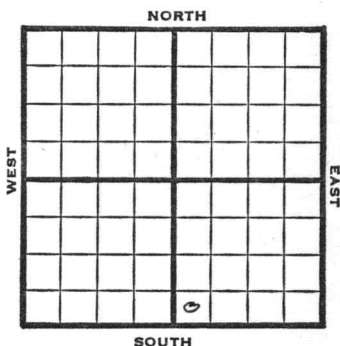

1948

Eli 1904'

R E P O R T

7/28

RUR

8/4

8" @ 520'

Drlg. 2170'

8/11

Drlg 3480'

8/18

Lansing ~~4084'~~ 3284' (Eod)

Cong 3252'

TD 3255' in Cong.

ABANDONED

Barton County Kansas State

Map No. _____ Sec. 26 Twp. 20 R. 14W

Well No. 1 Wyly

W. H. Black Company

FIRST REPORT

_____ Contractor

SW SE


SECTION PLAT

_____ Ft. from N. Line

330 Ft. from S. Line

_____ Ft. from E. Line

330 Ft. from W. Line

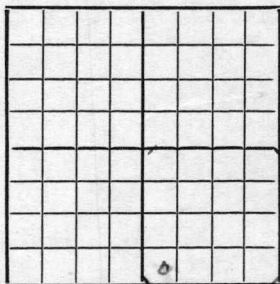

Prichard Pool

Remarks:

R U R

Date JUL 28 1948

Scout S. J. LEWIS

Barton County Kansas State

Map No. 82 Sec. 26 Twp. 20 R. 14W

Well No. 1 Wyly

W. H. Black Company

ABANDONED

Contractor

SW SE


E11904
SECTION PLAT

 Ft. from N. Line

330 Ft. from S. Line

 Ft. from E. Line

330 Ft. from W. Line

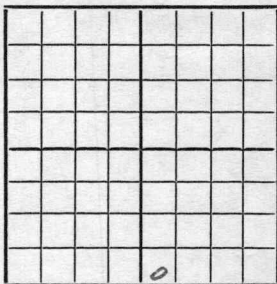

Prichard Pool

Remarks:

Line 3284

Comp 3252

FF 3255 in Comp

Date

AUG 18 1948

Scout

S. J. LEWIS