

KANSAS


FORM 51 5M BRIX

Barton County

Section 26 Township 20 Range 14W

Well No. #2 Tella Taylor

Company Gulf

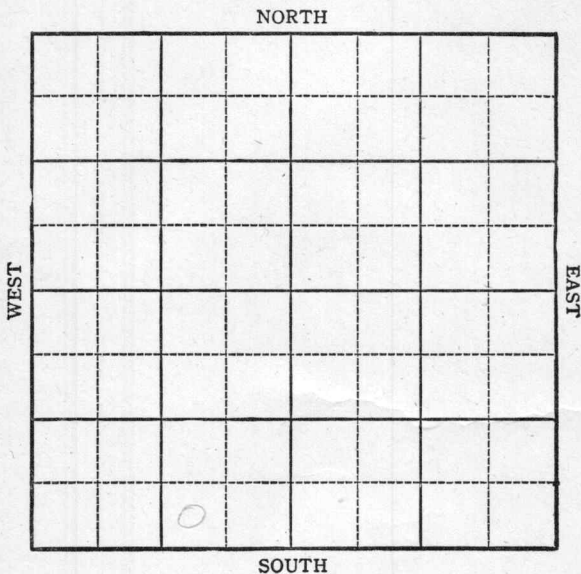

KANSAS

Barton County

Sec. 26 Twp. 20 R. 14W

Well No. #2 Tella Taylor Farm

Gulf

Company

Pritchard

Ft. from N. Line


330

Ft. from S. Line

990

Ft. from E. Line

Ft. from W. Line

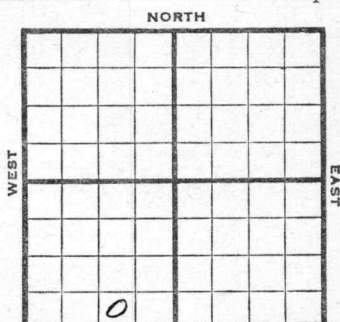

SW SE SW

Elev. 1905

SOUTH

1944

R E P O R T

11/1

Cellar

11/8

13" @ 239

8" @ 889

Drlg. 2050

11/16

Drlg. 3450'

11/24

Cong 3520 Arb 3522 TD 3600 SS0

5" @ 3599 RUST

11/29

31 shots 3545-3555 1000 accud Pump

115 oil in 9 hrs.

12/6

" " " " " " " " " "

12/14

" " " " " " " " " "

12/20

Arb. 3522

5" @ 3599

Perf. Arb.

1000 acid

TD 3600

Depth Pot 1080


38.9 Grav.

COMPLETE

Pool Name PritchardMap No. 82 Sec. 26 Twp. 20 R. 14WWell No. 2 Tella TaylorGulf CompanyFIRST REPORT Contractor

SW SE SW

SECTION PLAT

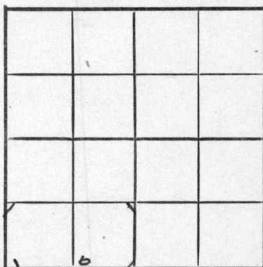 Ft. from N. Line330 Ft. from S. Line990 Ft. from E. Line Ft. from W. LineBartonLocation Rig up Drilling and Remarks;
cellar

RECORD

Cased in., ft.Sand Gas Oil Total Depth

PRODUCTION

1st 24 hrs. Nat. 1st 24 hrs. after shot Gas Cu. Ft.Dry Hole Abandoned

Date

NOV 1 1944 19S. J. LEWIS Scout

Pool Name PritchardMap No. 82 Sec. 26 Twp. 20 R. 14WWell No. 2 Tella TaylorGulf

Company

COMPLETED

Contractor

SW SE SW

SECTION PLAT

 Ft. from N. Line330 Ft. from S. Line990 Ft. from E. Line Ft. from W. LineBarton CountyLocation Rig up

Drilling and Remarks:


RECORD

Cased in., ft.Sand Gas Oil Total Depth 9600

PRODUCTION

1st 24 hrs. Nat. 1st 24 hrs. after shot Gas Cu. Ft.Dry Hole Abandoned

Date

DEC 20 194419S. J. LEWIS

Scout